24

Sec. 5 T. 1 N R 5 E

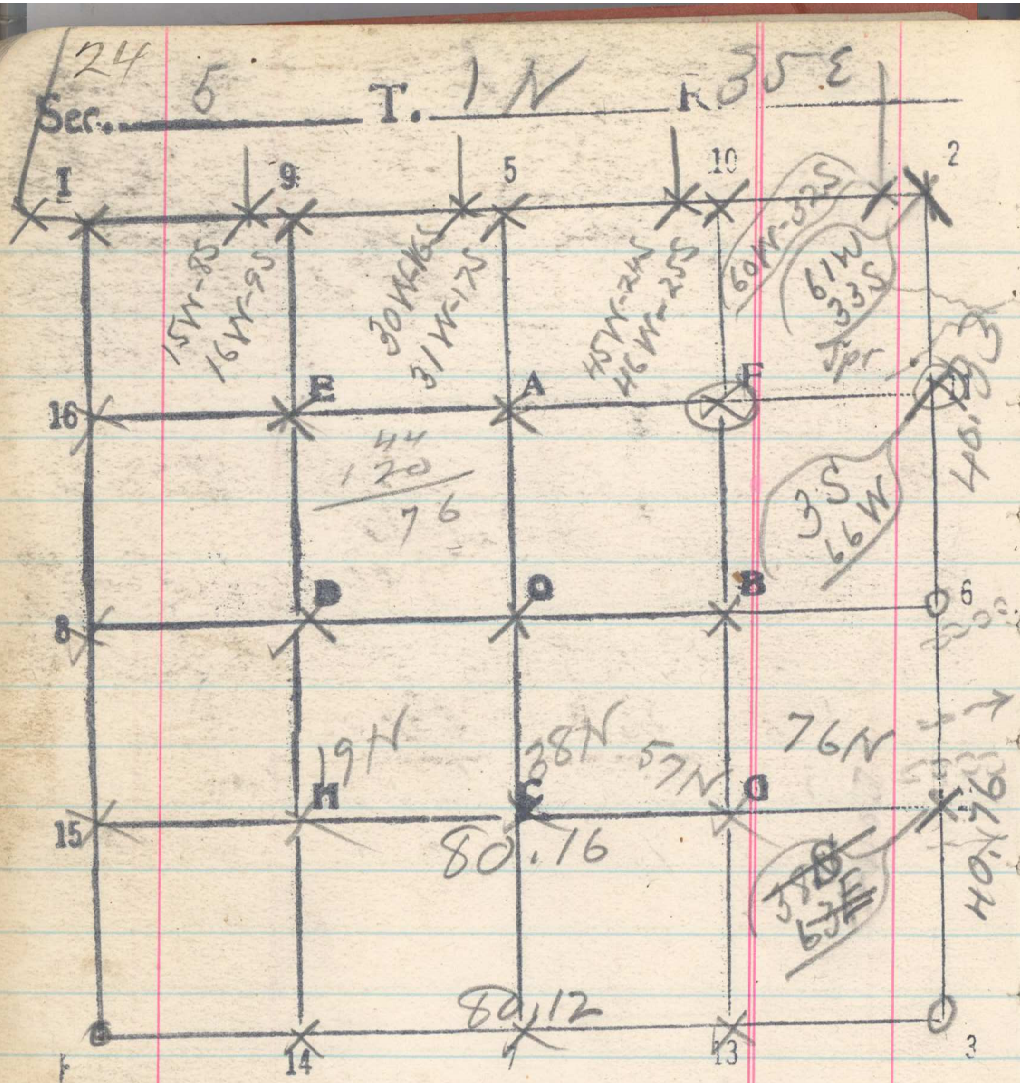

This cor is a pine 8 ins marked on W side (extended as fire 10 ins)
Pine 12 bears S 82° E 26 links
Fir 22 bears N 60° W 16 links

Thence run North by B.S. on record desc in timber, on W slope

20 Set 1/16
24.65 Canyon, water in pool N 75° E
27.30 Ridge, slopes E
31.00 Canyon, S 70° E leave timber July 21, 1917
40.66 Temp. C C of secs 4 + 5 set from W bears N. 72 lks.
40.33 Corrected C C of secs 4 + 5 bears W 72 + 61 = 133 lks.

N bet. 4 + 5 in timber

18.00 Head of gulch, E.
20.24 Set 1/16 Right slope E.
28.00 Head of gulch E
35.00 Pine, 8 ins N 60° E
40.76 1/4 corner 4 + 5 bears E. 126 lks.