


16 8 T. 2 N R. 8 E

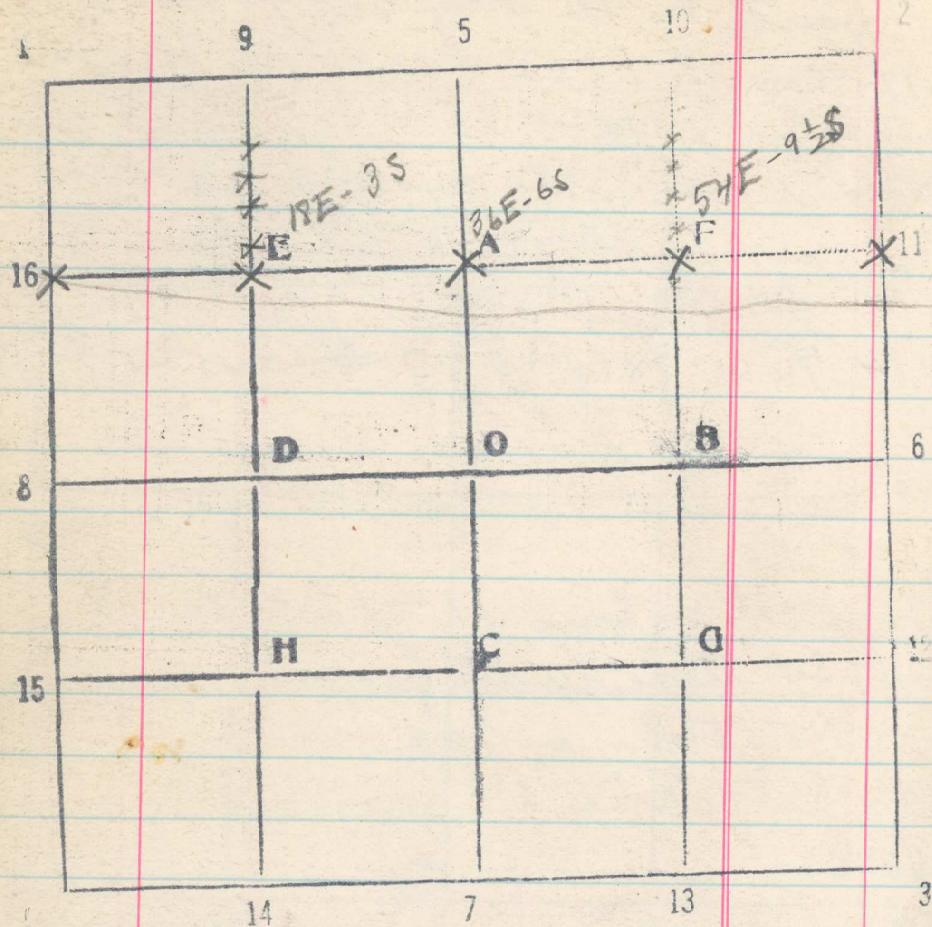

251

Line 16-11

20.28 Fence, N + S
 40.83 Fence, N + S
 60.43 Fence, N + S

80.72 Cor. 16 bears S 12 W 1/2 Sec July 8, 1919