41

Sec. 3 T. 2 R. 33

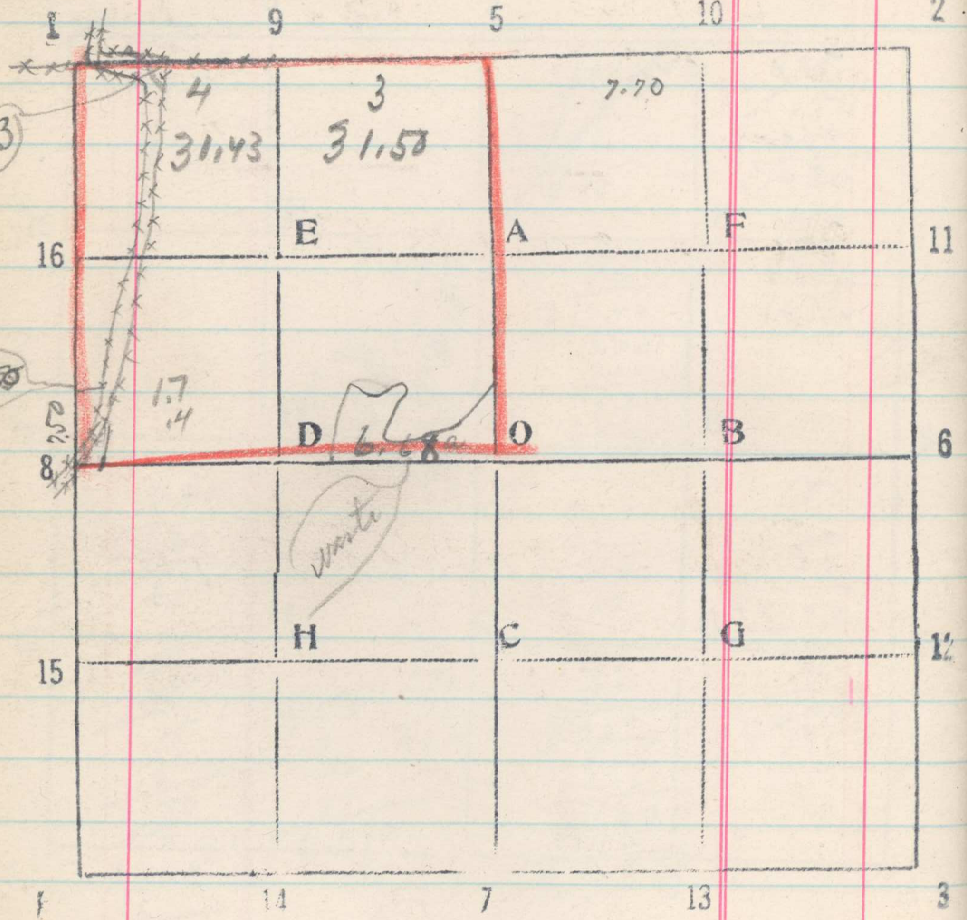

Waste Land.

In S.E. corner	6.68 a.	6.68
In S.W. corner	1.70 a	1.70
N. part, E. of road.	.3 a	.3
Total waste	8.68 a	8.68

Road, 40 chs long, 75 lks. wide, 3. acres.

Total in waste & road 11.68 a

Total area of allotment 142 93

11 68

Area of cultivated land. 131 25