


Sec. 25 T. 2N R. 38E

Examiner _____ Date 3/19 1918

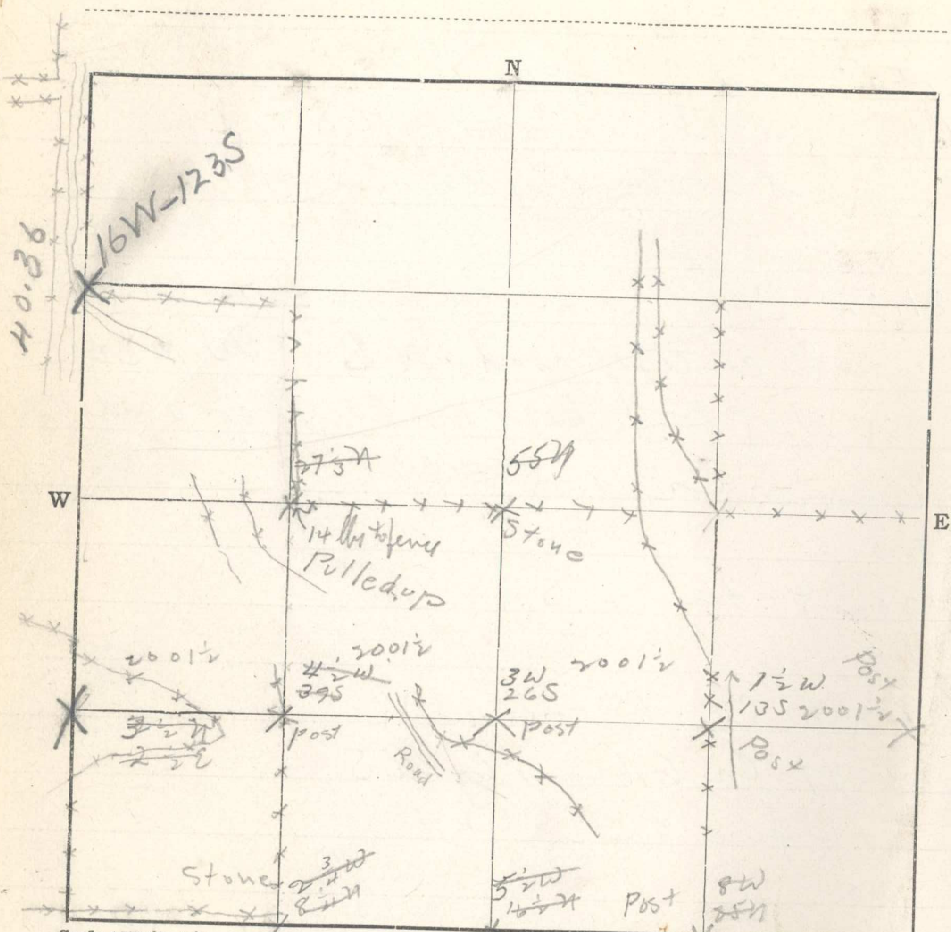

Scale 1320 ft. 1 in.

$$\begin{array}{r} 3\frac{1}{2} \\ 2\frac{1}{3} \\ \hline 5\frac{2}{3} \end{array}$$

$$\begin{array}{r} 5\frac{1}{2} \\ 2\frac{1}{2} \\ \hline 8 \end{array}$$

$$\begin{array}{r} 1\frac{1}{4} \\ 1\frac{1}{8} \\ \hline 1.23 \end{array}$$

329

2 lot no. 25 + 26
Begin at NW cor 25 in same line as
lot 23 + 24

81 + 05 center E + W lane

100 set stake

121 + 41 1/4 cor bet 25 + 26 bears E 4 lbs

20 set stake

3993 cor of sec 25, 26, 31 + 36 bears E 5 lbs

4/3 - W from cor 12

20 from N + S

40

60 from N + S

8006 Cor 15 bears S 52 lbs

E from cor 8

20

40

60 1/4 cor set properly bears 82 lbs N

8007 Cor 6 bears N 112 lbs