


Sec. 28 T 2 N R. 33 E

Examiner Date 3/19 1918

18 1/2
7

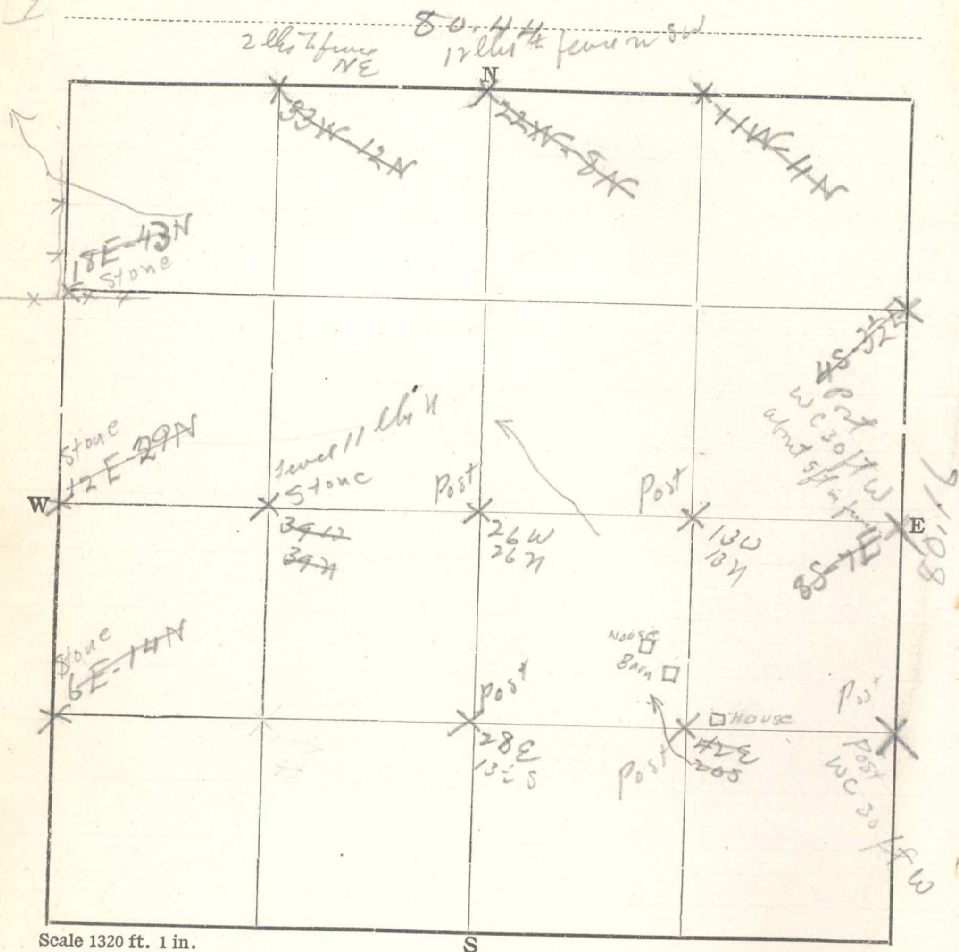

N bit near 28029

331

20 net taken

40 " "

5978 fence E+W

60 net taken

8058 Cr 1-528 bears E 28 lbs.

W from Cr 6-528

Fence N+S

20

40

4027 Fence N+S

60 net taken

6043 Fence N

6065 Fence S

8052 Cr 8 bears N 52 lbs.

E from Cr 15-528

2004 Fence N+S

40

4024 Fence N+S

60

8056 Cr 12 bears S 27 lbs.