Sec. 26 T. 2 R. 33

Examiner ..... Date ..... 19....

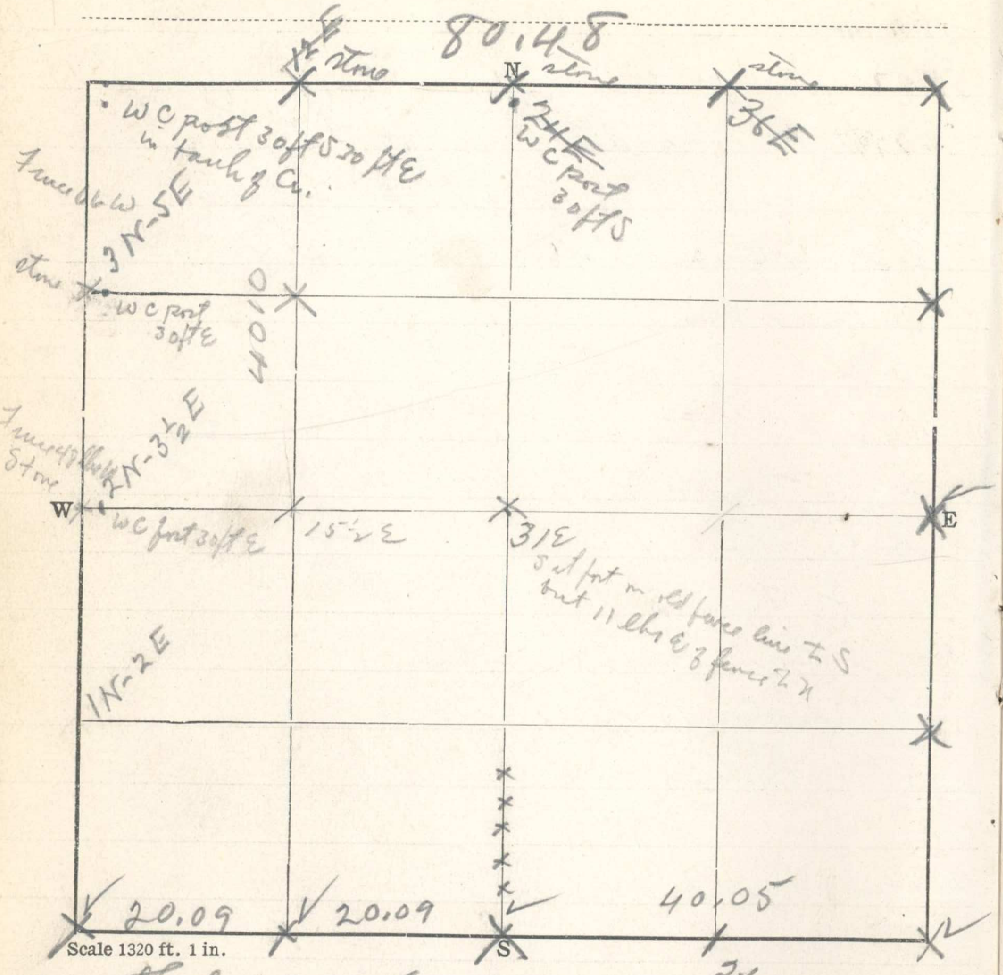


Meanders. 26 & 35 In road, 2¼

19.94 Fence, N.

20. Set

40.05 Intersect 1/4 Cor. a stone mkd 1/4 on S face ~~of~~ road, on line with fences to N

Thence West

20.09 1/16 Cor. a stone, 13 lks S. of line

40.18 Cor of secs. 26.27.34 & 35, remains of MS. 28 lks. S. of line, Sd stone

Form No. 300 SHAW & BORDEN CO. 160 75

E from Cor 8-526

20 set

40 set

4020 fence N & S

6049 ¼ cor in place bears S lks from straight line

906 Cor 6 & 26

March 28

S from Cor 9-526

20 set post

4010 Cor D-526