


Sec. 35 T. 2 N R. 37 33 E

Examiner Date 3/30 19

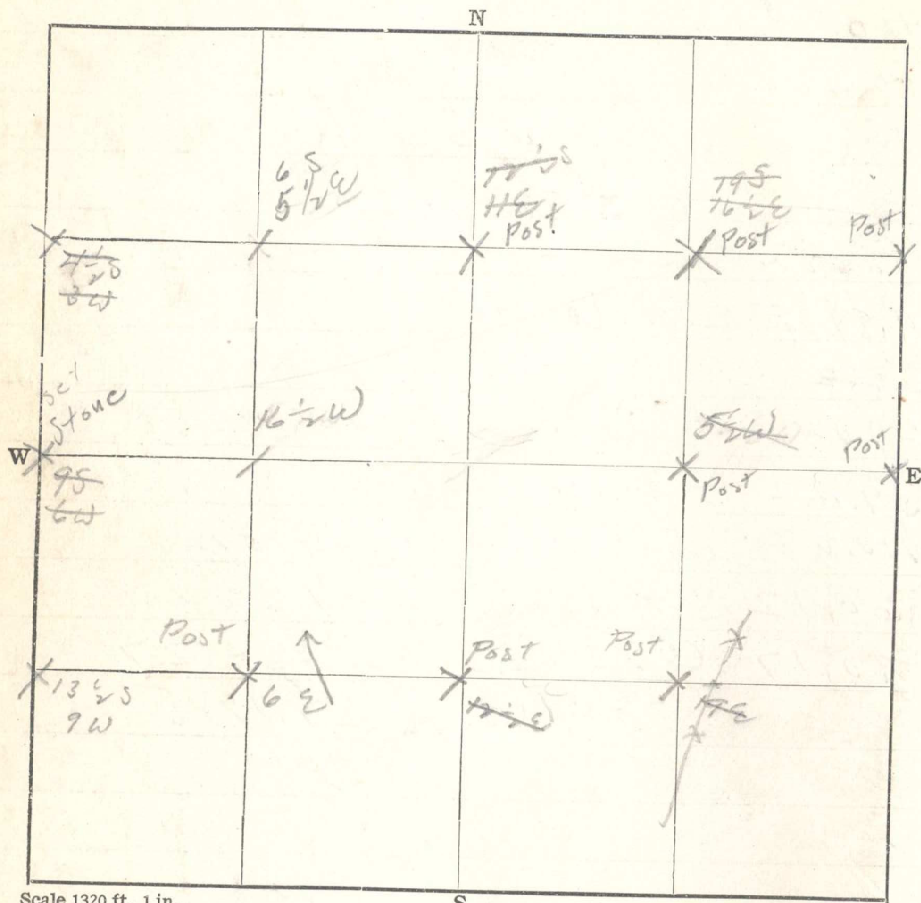

Scale 1320 ft. 1 in.

Fence Co 1 runs S

20

3998 Fence E+W

40

60

8018 Co 4 bears W 12 lbs

April 2

Co from Co 15

334

20

2005 Fence N+S

40

60

6320 Fence N 15 E + S 15 W

8025 Co 12 on line

W from Co 6 - 835

20

60

6014 Fence N+S

8022 Co 8 on line

E from Co 16

20

2005 Fence N+S

40

60

8022 Co 6 bears S 25 lbs