Sec. 14 T. 2 R. 33

Examiner ..... Date 4/4 19....

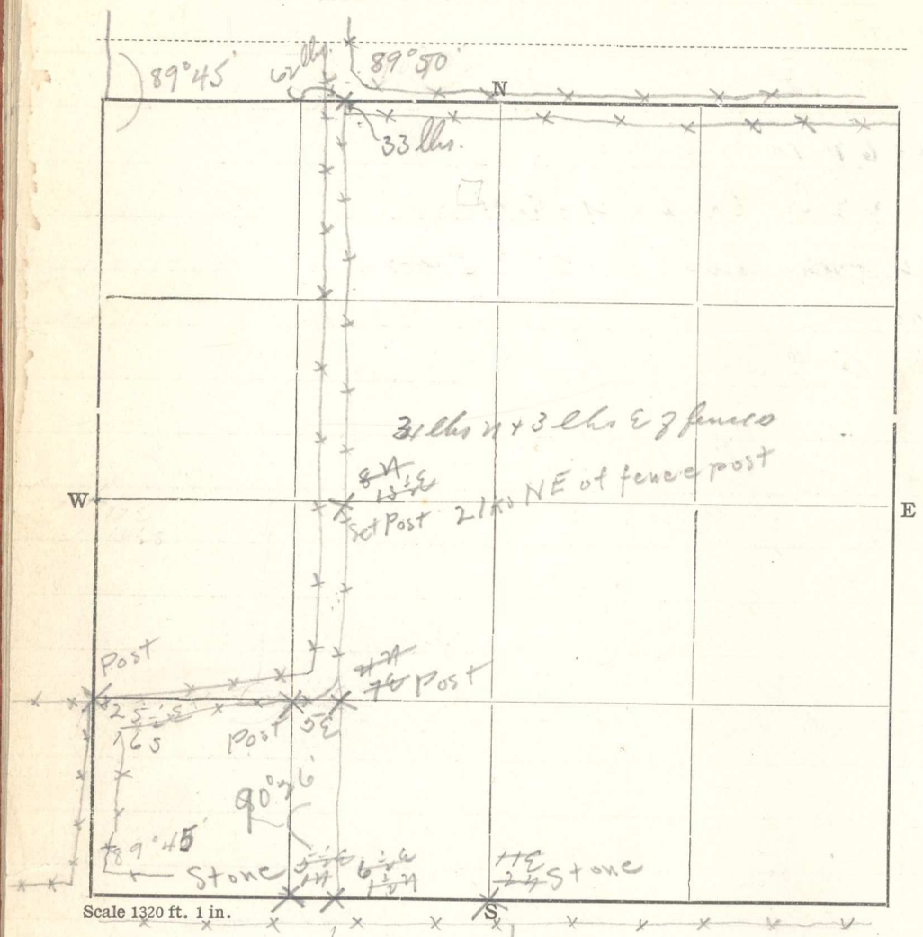

S from Cor 1 - Tachujit in Cor 8-S 11

40

60 Fence E+W

8021 Cor 4 bears E 34 lks.

E from Cor 4

20

24

40

4062 Fence on S

80 x 2 Cor 3 bears N 4 lks.

N from point 24.06 ± E of Cor 3

20

2004 Line of fence from EW

40

8016 Cor at 24 lks E of Cor 1 bears E 27 lks.

E from Cor 15

20

2405 Cor stake for Indian school

336

Form No. 300 SHAW & BORDEN CO. 160 75

Form No. 300 SHAW & BORDEN CO. 160 75