27

Sec. 5 T. 2N R. 3HE

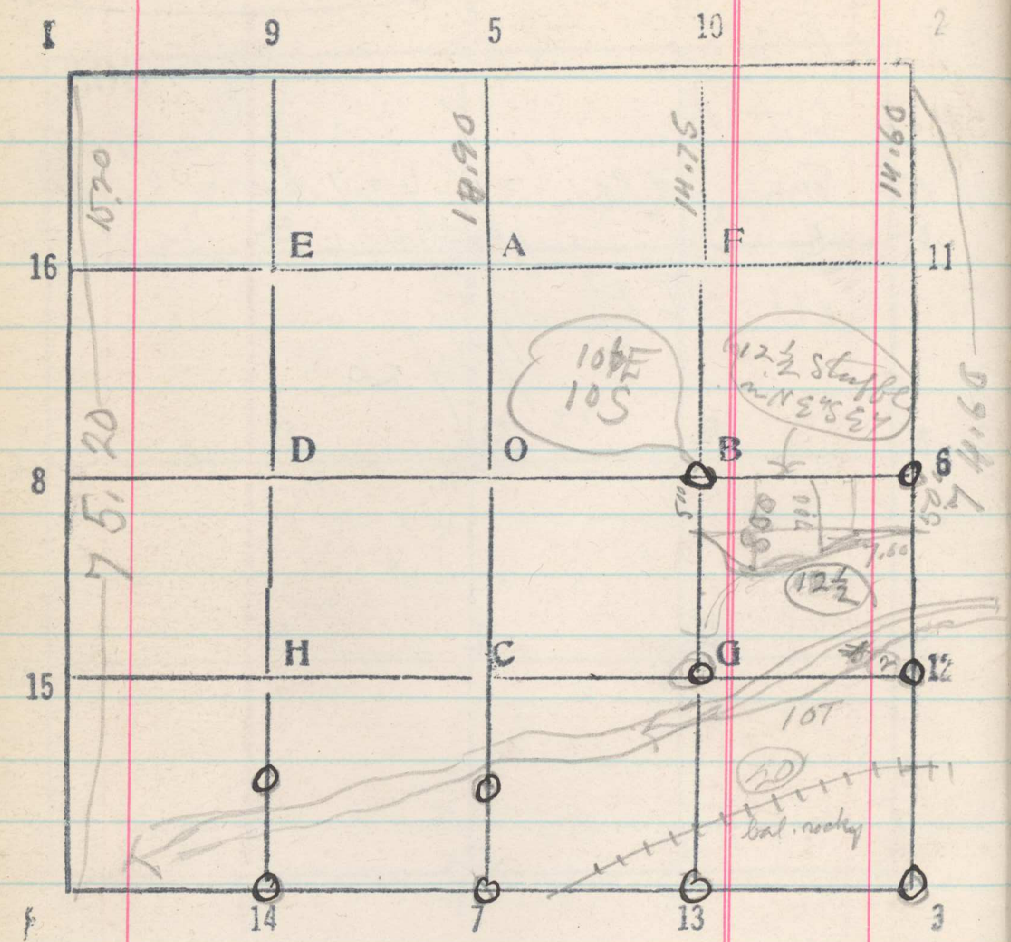

56 N 67 W 3

166

107 E

3

3

105

309