


82  
45 Sec. 17 T. 2 R. 34

2/37 Examiner Date 4/7 1918

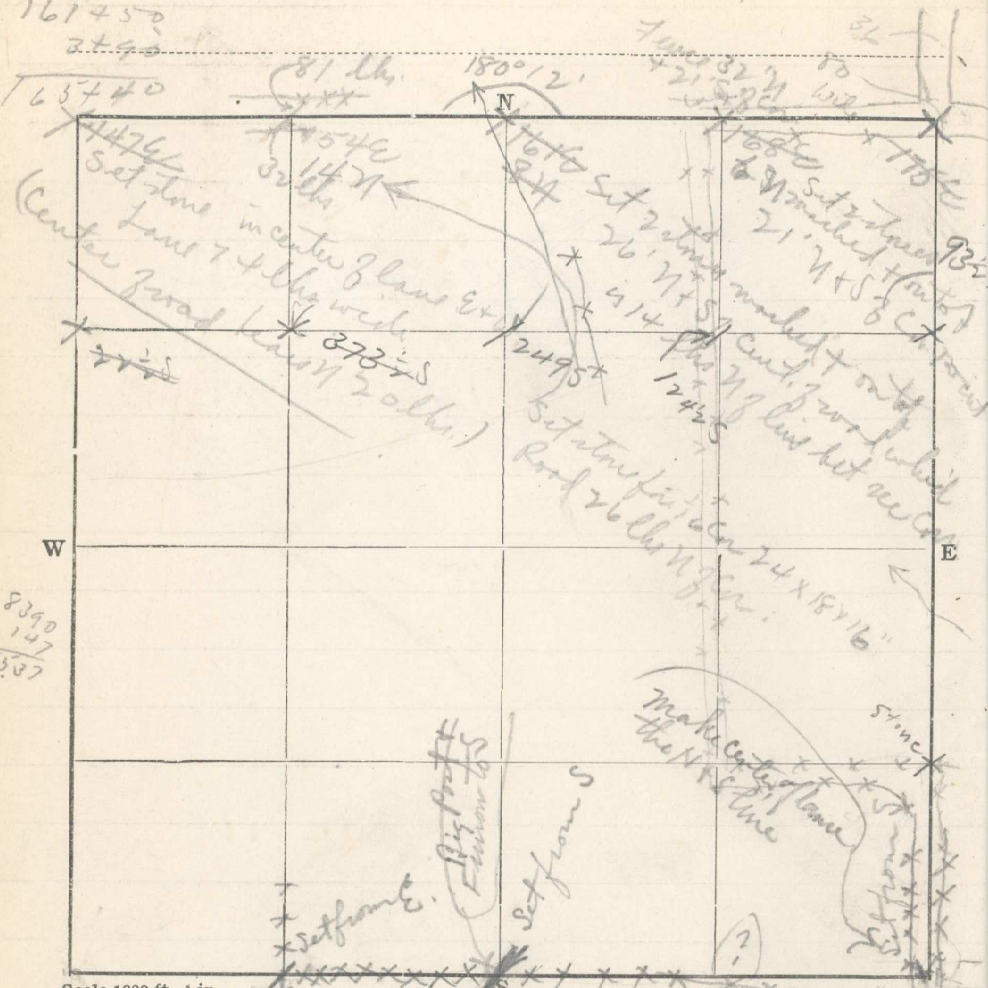

Scale 1320 ft. 1 in.

E from same line as on S of Sec 7 project

20 +88 } fence to S  
 40 #1 } fence to S  
 60 +124 } fence to S

8150 Center of lane to N - Center of both lanes bears 12 lbs S. Set stone -

This stone is 165.40 chs E of Cor 4-57

at Cor 10 - center of lane to S is 63 1/2 chs 347  
 79 Set stone in center of lane 43 lbs wide for temp Cor 3  
 and run N - Stone is moved 24 1/2 chs

20 + 0.3 fence E+W

40

60

8036 Cor 2 on line

5/20 W from Cor 11

20 + 25 fence N+S + 59 fence N+S

40

60

80 Cor 16 bears 5 4.98 chs.