



Sec. 20 T. 2 R. 34

Examiner 81 Date 5/6 1918

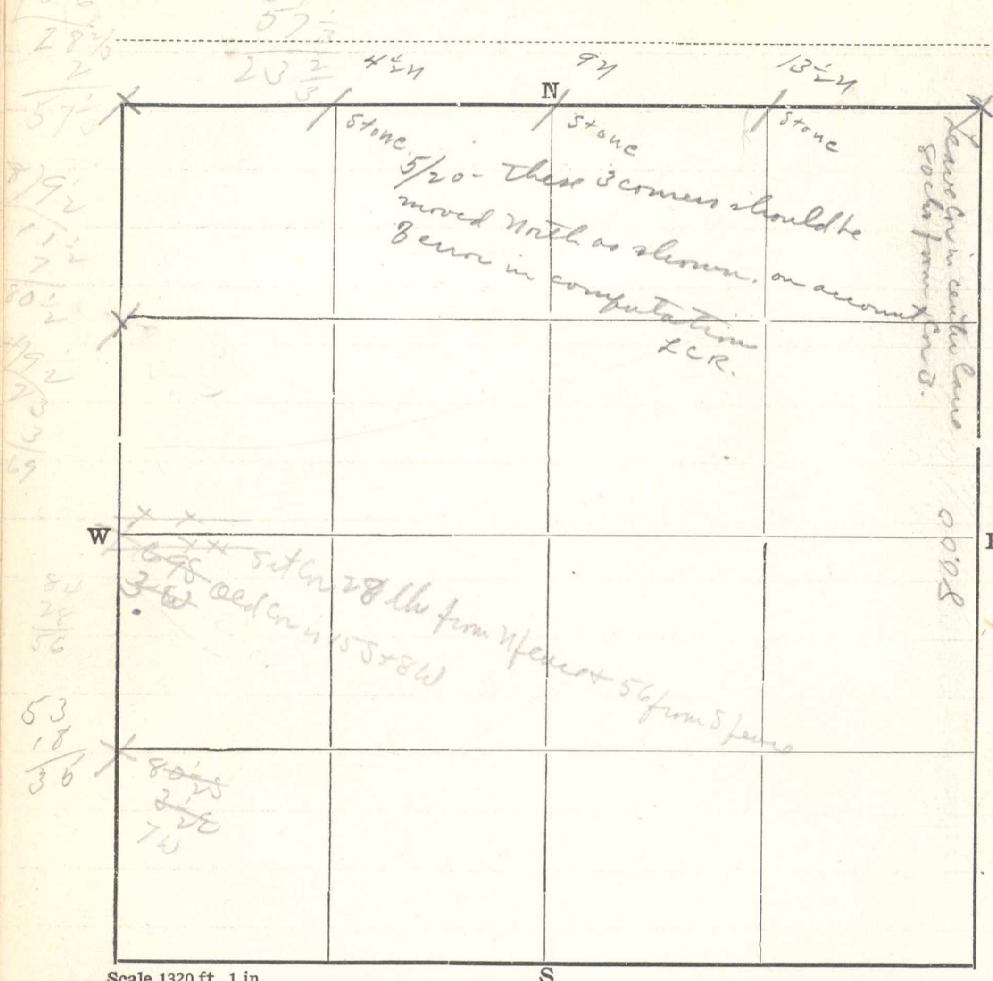

5/11 S from rock stake 87 Cr 1-517
 2086 lbs Temp Cr 8-5 20 bears W 12 lbs
 140 Temp in Cr in 8 Sand 12 W 20 lbs
 160.92 Cr 4 bears E 4 lbs

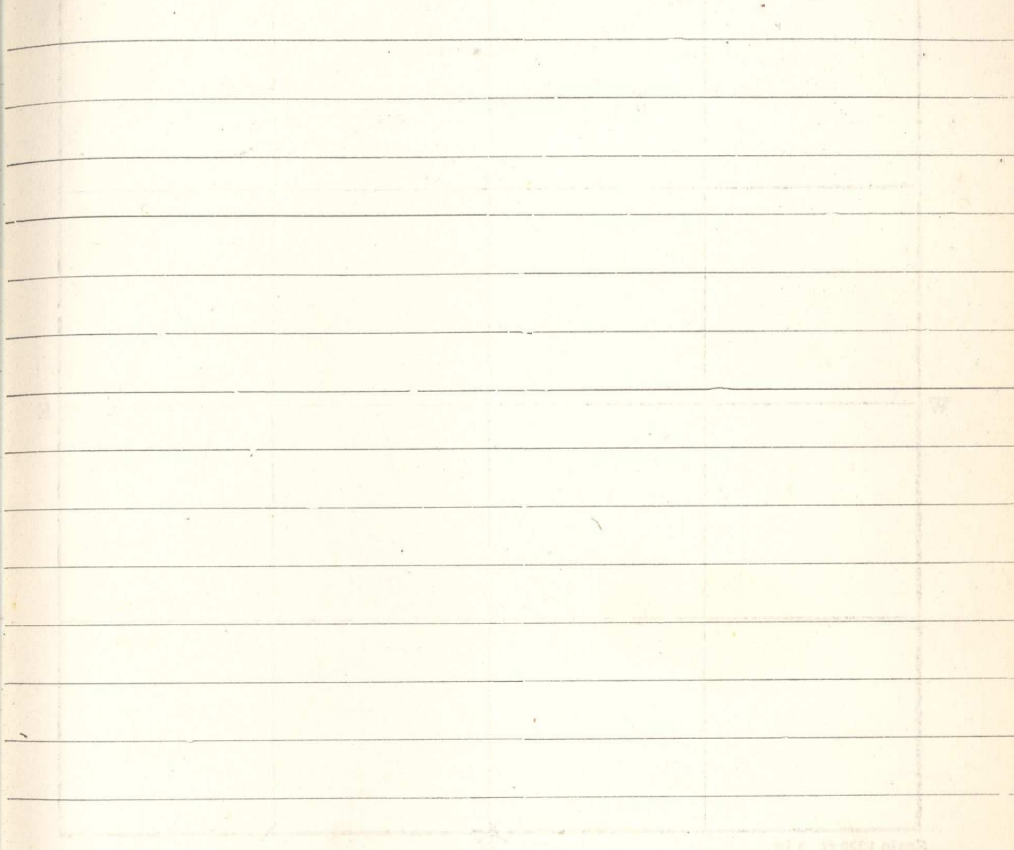

Scale 1320 ft. 1 in.

Some same line + measure bet 17 + 18
 180 + 59 fence 9 + W
 120.86 Temp in 8 bears W 12 lbs
 W from point 53 lbs S 7 Temp Cr 2
 20 + 23 - old 20 ch stake
 40 + 16 fence N + S
 79.98 Cr 4 bears N 35 lbs