


46 28 T. 2 N R 35 E
Sec. _____

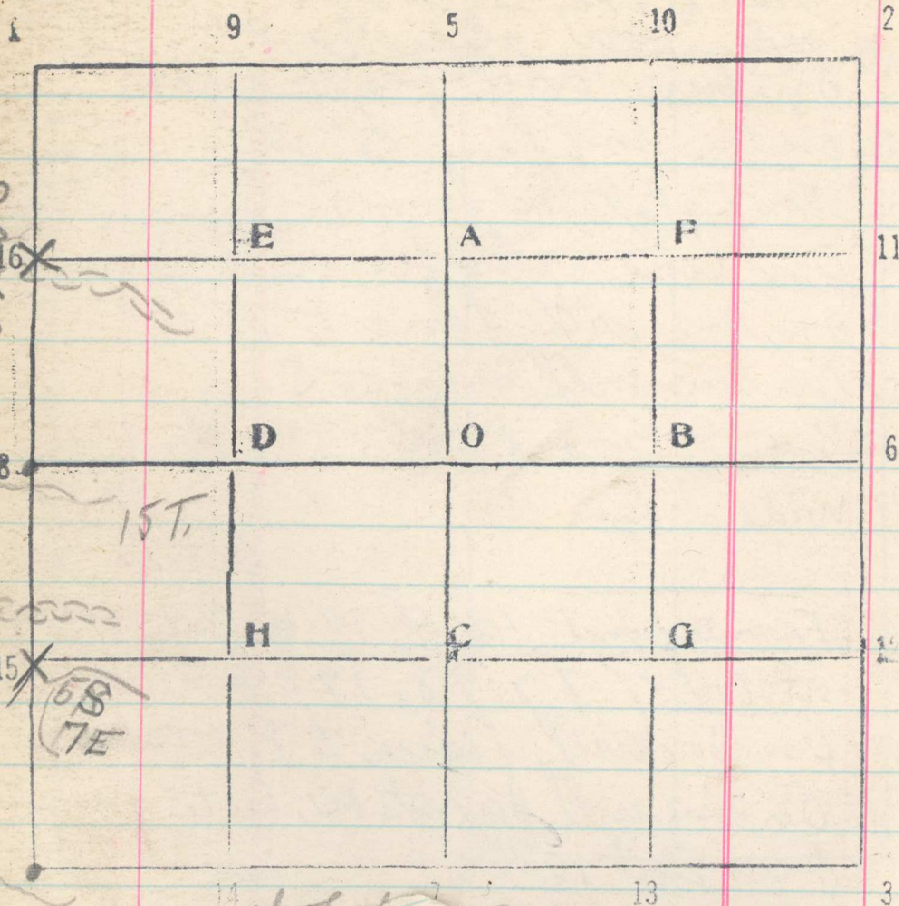

281

North 28 29
Set 1/16
39.90 1/4 cor. anton in MS, beans 14 lb
Phenex Nov
Set 1/16
27.56 Cov of mees 20, 28 + 29 beans W. Holler
Oct. 21, 1919