3

Sec. 22 T. 2N R. 35E

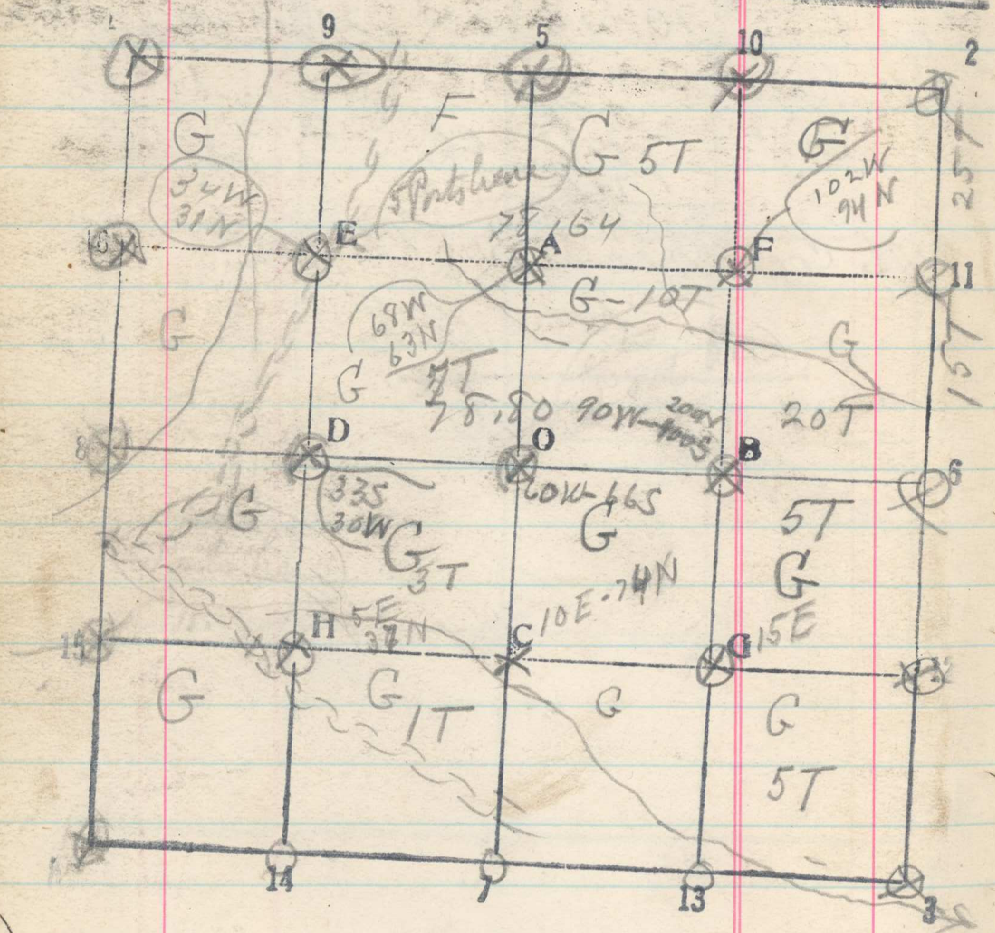

Line 16-11 Set 20, 40 & 60

78.64 Cov, 11 bears N. 126 lks.

from 1/4 cor bet 21 & 22

~~4.175~~

20.87 285

run N 89° 13' E through Center Sec 22

Set 20.40 & 60

78,80 1/4 cor bet secs 22 & 23 bears

S: 134 lks

Nov 13, 1919

2)134
2)67
33

300
166
134

S 89° E on Line 15-12

Set 19.70, 39,40 & 59,10

19.90
79.00

300N
100S
200N

79.10 Cov 12 bears N. 148 lks.

Nov 14, 1919