Sec. 5 T. 2 N R. 3 E of 5.5

Examiner Date 19

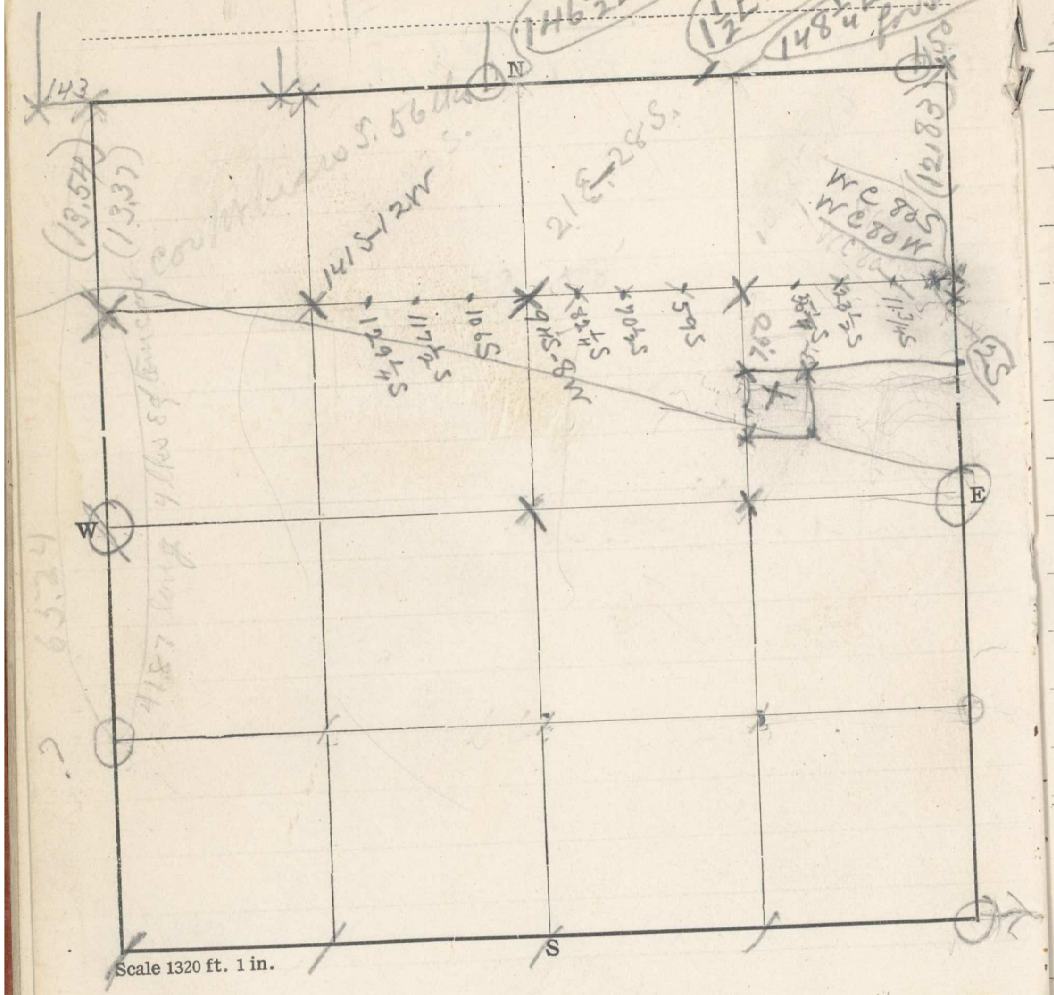

From 15 to 16. 4187 chs 4 lks E of Tenn 16 cor

From 15 to CC cor 13.37, CC bears E 7 lks

From 1/4 cor bet Secs 4 & 5 run W

19.37 Base S. 3.00 chs

20.00 Set 1/16 cor post

29.16 Angle to S end of base

30.00

40

60

78.76. Tenn 1/16 cor 8 bears S. 22 lks dist

From 1/16 cor 15 run E.

20.00 Set tenn 1/16 cor

40.00 Set 1/16 cor

60.00 Set tenn 1/16 cor

78.52 - 1/16 cor 12 bears N 20½ lks dist.