Sec. 8 T. 2N R. 35E

Examiner Corrections completed in Sec 6 Date 19

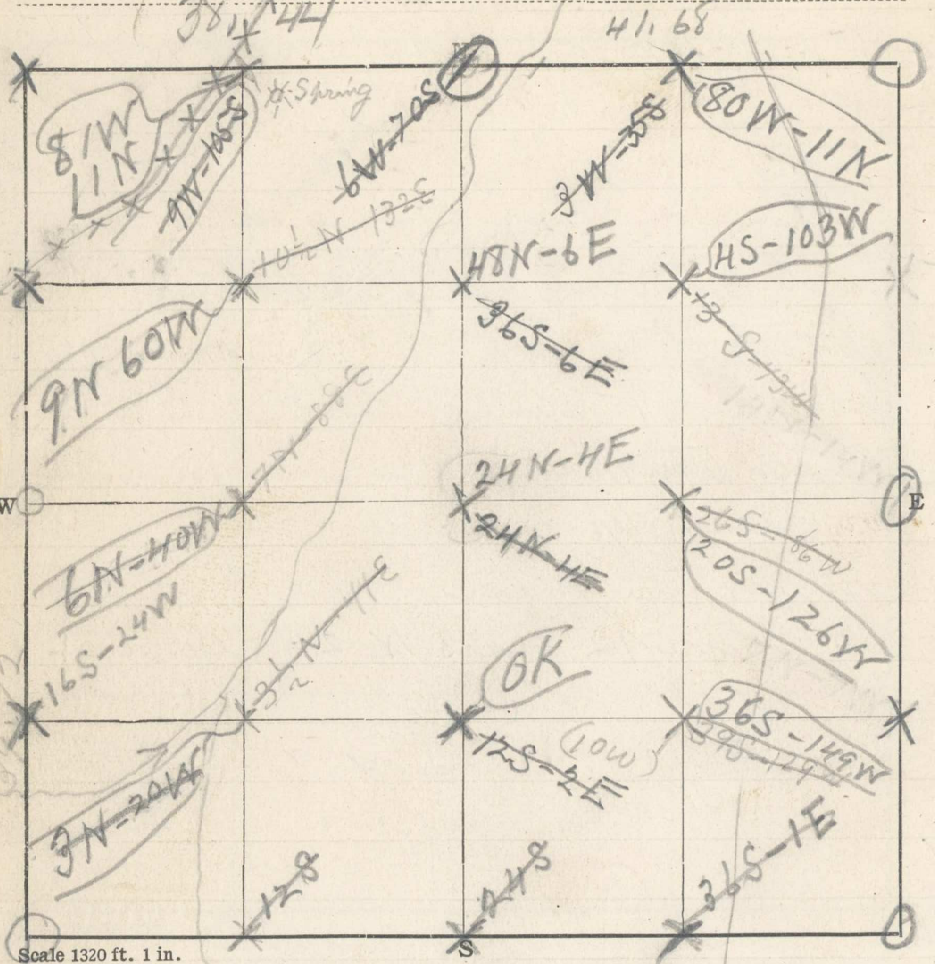

From 1/16 cor (9) run North

20.00 Set tem 1/16 cor

40.00 Set tem 1/4 cor

60.00 Set tem 1/16 cor

80.14 (9) bears E. 1.76 lks dist

45°

17

1/4

No. 360 SHAW & BORDEN CO. '6) 75

28

29

From 1/4 cor bet secs 19 & 20 run North

20. Set 1/16 cor

40. No trace of cor of 17, 18, 19 & 20. Set stake North on same line bet 17 & 18

20 Set 1/16 cor

40 Set stake

40.36 Remains of Md stone bears West 17 lks. Evidently 1/4 cor but no stone marked.

45° 41 to camp. C.E.R.

80.38 Cor to secs 7, 8, 17 & 18 bears W 23 lks

North bet secs 7 & 8

20.00 Set tem 1/16 cor

39.72 Original 1/4 sec cor bears W 48 lks Stone in md of stone

From tem 1/4 cor bet secs 8 & 17 run North

20.00 Set tem 1/16 cor

40.00 Set tem 1/4 cor

60.00 Set tem 1/16 cor

79.52 1/4 sec cor bet Secs 5 & 8 bears E 8/10 lks

From 1/16 cor (10) run north Aug 13

20.00 Set tem 1/16 cor

40.00 Set tem 1/4 cor

60.00 Set tem 1/16 cor

80.52 1/16 cor (13) bears W 172 lks dist

13

43