


34 Sec. 9 T. 2N R. 35E.

Examiner ..... Date ..... 19.....

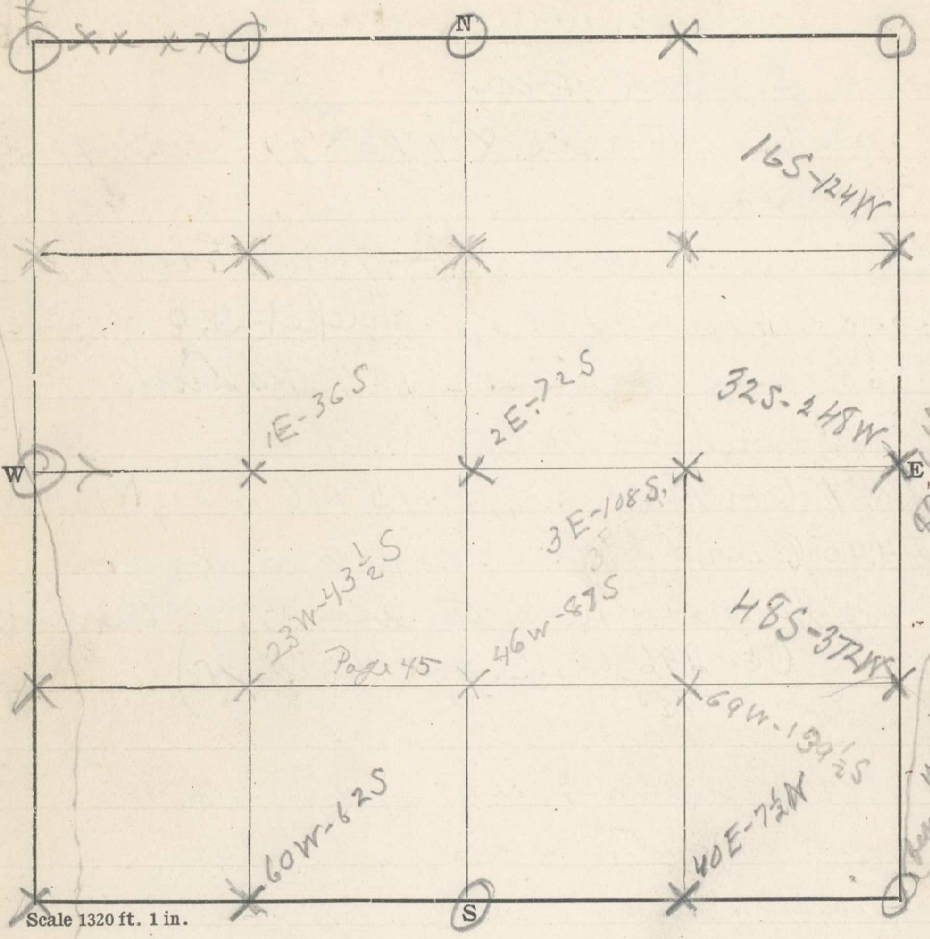

Scale 1320 ft. 1 in.

From cor to sec 3, 4, 9 & 10 Run South  
bet sec 9 & 10

370

2000. Set tem  $\frac{1}{16}$  cor  
4000 Trailed to find old  $\frac{1}{4}$  cor. Set tem  $\frac{1}{4}$  cor  
6000 Set tem  $\frac{1}{16}$  cor,  
8000 On top of ridge. Trailed to find  
old cor. Set tem cor to Secs 9, 10, 15 & 16  
Stone marked + on top 111 on E & 111 on S  
with lumber pencil.  
80.64 Old cor of sec 9, 10, 15 & 16 bears W. 496 lks.

South bet sec 15 & 16

20.00 Set tem  $\frac{1}{16}$  cor  
40.00 Set rock marked Tem  $\frac{1}{4}$   
57.45 Set Mt maple stake marked  
57.45 in gulch bed and gashome  
(From  $\frac{1}{4}$  cor bet. Secs 8 & 9 run East  
20.00 Set tem  $\frac{1}{16}$  cor  
40.00 Set tem  $\frac{1}{4}$  cor  
60.00 Set tem  $\frac{1}{16}$  cor in thicket  
80.04 corrected  $\frac{1}{4}$  cor bears S 144 lks