


40 Sec. 3 T. 2 N R. 35 E

Examiner \_\_\_\_\_ Date \_\_\_\_\_ 19\_\_\_\_

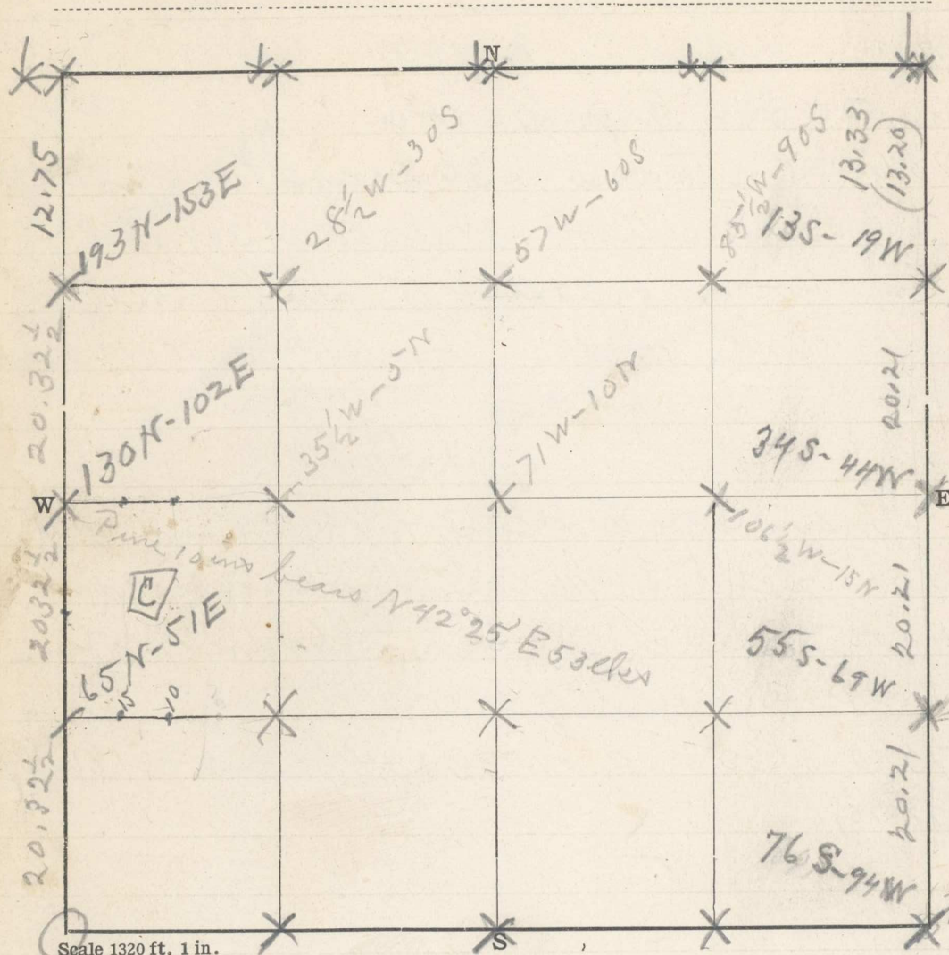

From 1/4 cor to 1/16 cor

From CC. to Secs 2 & 3. run South  
 13.20 Set term 1/16 cor  
 33.20. no sign of old cor. Set term 1/4 cor 373  
 53.20 Set term 1/16 cor  
 74.64 Possible original cor bears W 56 lbs  
 Set term cor to secs 2, 3, 10 x 11

From 1/4 cor bet secs 3 & 4 Run E.  
 20.00 Set term 1/16 cor  
 40.00 Set term 1/4 cor.  
 60.00 Set term 1/16 cor  
 78.58 Corrected 1/4 cor bet secs 2 & 3 bears N 20 lbs

From 1/16 cor 16 run East  
 20.00 Set term 1/16 cor.  
 40.00 Set term 1/16 cor A  
 60.00 Set term 1/16 cor F  
 78.86 1/16 cor 11 bears S 120 lbs dist

From 1/16 cor (12) run West  
 20.00 Set term 1/16 cor (12)  
 40.00 Set term 1/16 cor (C) Aug 19