Sec. 20 T. 2 N R. 33 E

Examiner ..... Date ..... 19....

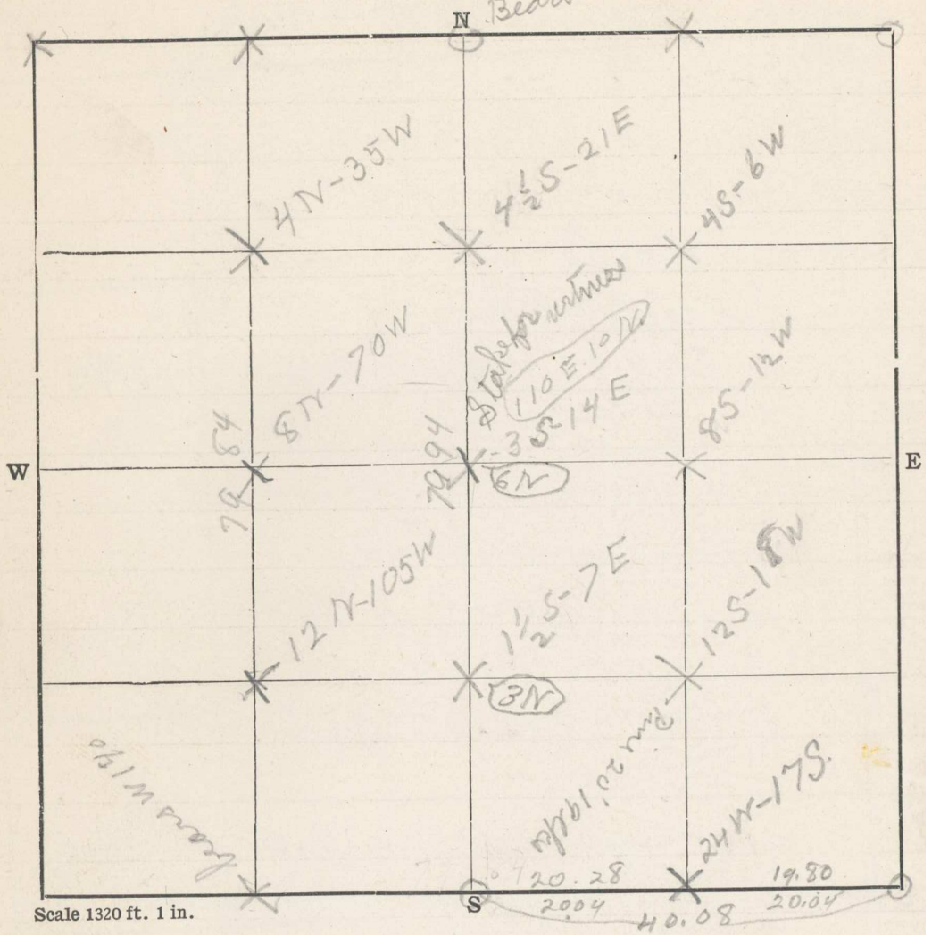

From 1/16 cor 10 run South
20.00 Set Tem 1/16 cor F
40.00 Set Tem 1/16 cor B
60.00 Set tem 1/16 cor G. 3 lks W of pine 20 inch diam
80.17. 1/16 cor-13-bears West 24 lks

From tem 1/16 cor-13 run East
19.80 Cor to secs 20.21, 28.29 bears S 6½ lks

From 1/16(9) run South
20.00 Set tem 1/16 cor E
40.00 Set tem 1/16 cor D
60.00 Set tem 1/16 cor H
79.84. 1/16 cor (14) bears W. 14 0 lks
From tem 1/16 cor (13) run W.
20.28 1/4 sec cor bears S 27 lks

Thence North through center of sec 20 from 1/4 cor
20.00 Set Tem 1/16 cor C
40.00 Set Tem 1/4 cor O
60.00 Set tem 1/16 cor A
79.94 1/4 cor bet secs 17 & 20 bears East 29 lks