


21
Sec. 8 T. 2N R. 36E

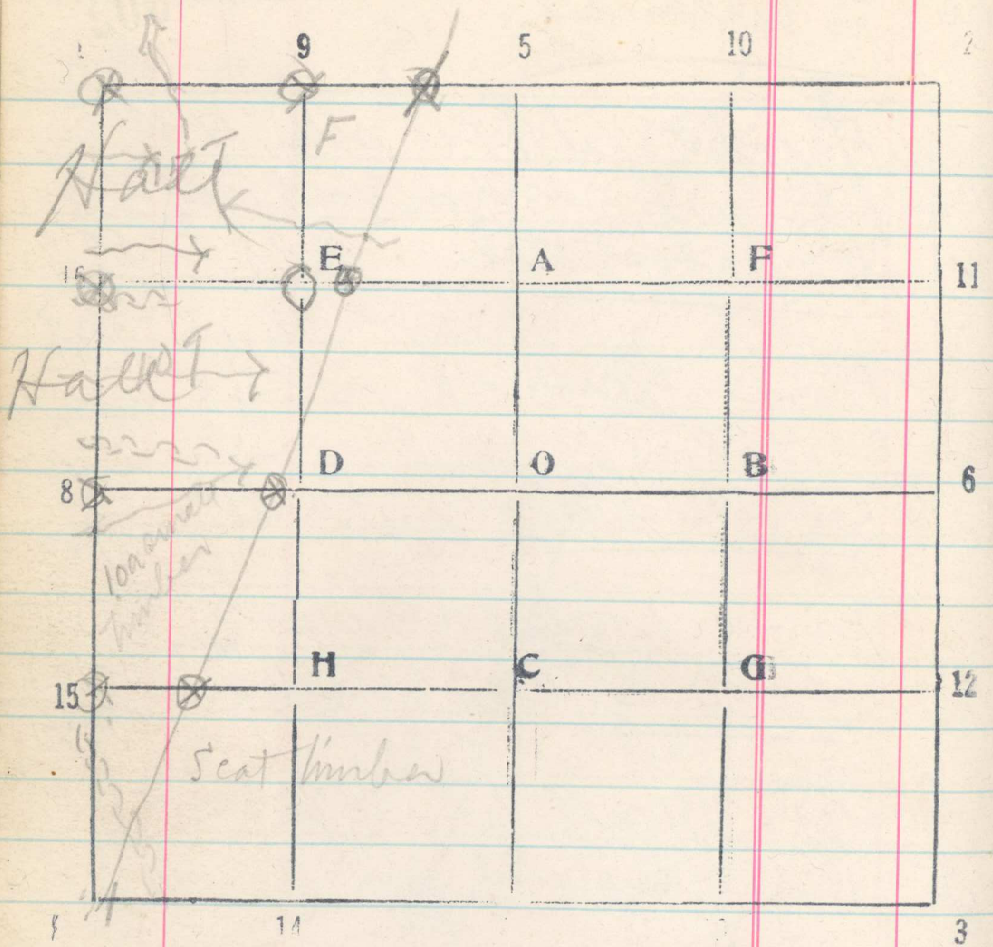

303