


48
 Sec. 32 T. 34 N. R. 35 E

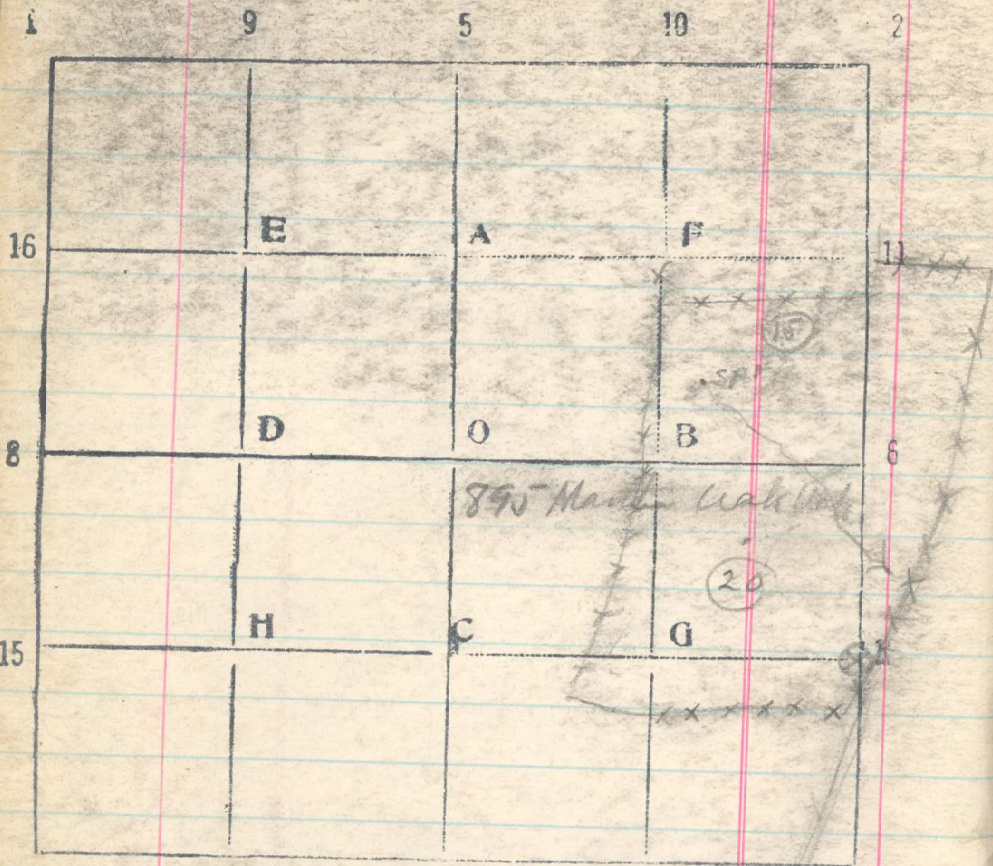

July 17th 1897. Charles Sears Claim N 81 S 55"
 sec. 32 T. 34 N. R. 35 E. Reason of digging out spring
 was nearly past 7 years, and fastening about 16
 work horses + 2 or three cows on this land + land
 joining, which was enclosed by fence
 made understand, by witnesses, the claims

to get the fence up after the morning
 of the 17th, so the year had passed a year
 since when he has not kept fence
 by him, because this summer he 283
 he dug the spring out last year
 this block has watered at the spring
 Wm. Hall also pastured from 15 to 20
 head of his cattle in the pasture
 in spring, that no one but Sears + Wm. Hall
 had kept stock in pasture.