


31
 Sec. 21 T. 3N R. 36E

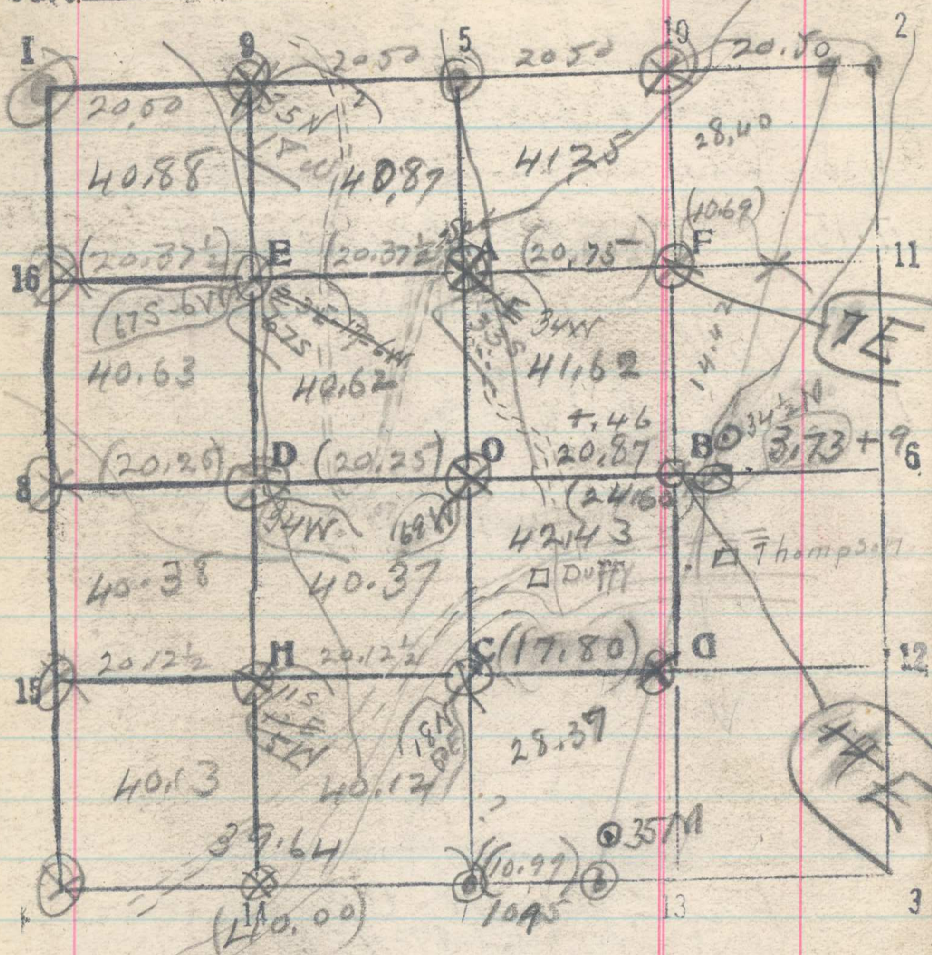

Line 0-7

39.64 1/4 cor bet runs 21 & 28 bears W. 186 lks.

Line 7-5

266

Cor O bears E. 169 lks.
 Temp Cor A bears E. 173 lks
 1/4 cor bet 16 & 21 bears E. 200 lks
 8/19/19
 28 W. -

24.60			
10.99			
<u>2</u> 35.59			
17.795	17.80		17.80
	24.60		18.99
	<u>42.40</u>		<u>28.79</u>
20.87,			4.00
12.8	55	25	2.5
4.00	4.00		5.29
	<u>3.73</u>		<u>2.3</u>
25.15	3.83		12.5
24.60	4.00		<u>20</u>
	<u>7.5</u>		
55	.17		
20.87	18	3.73	
<u>42.1</u>	<u>28</u>		
9	46	<u>3.82</u>	