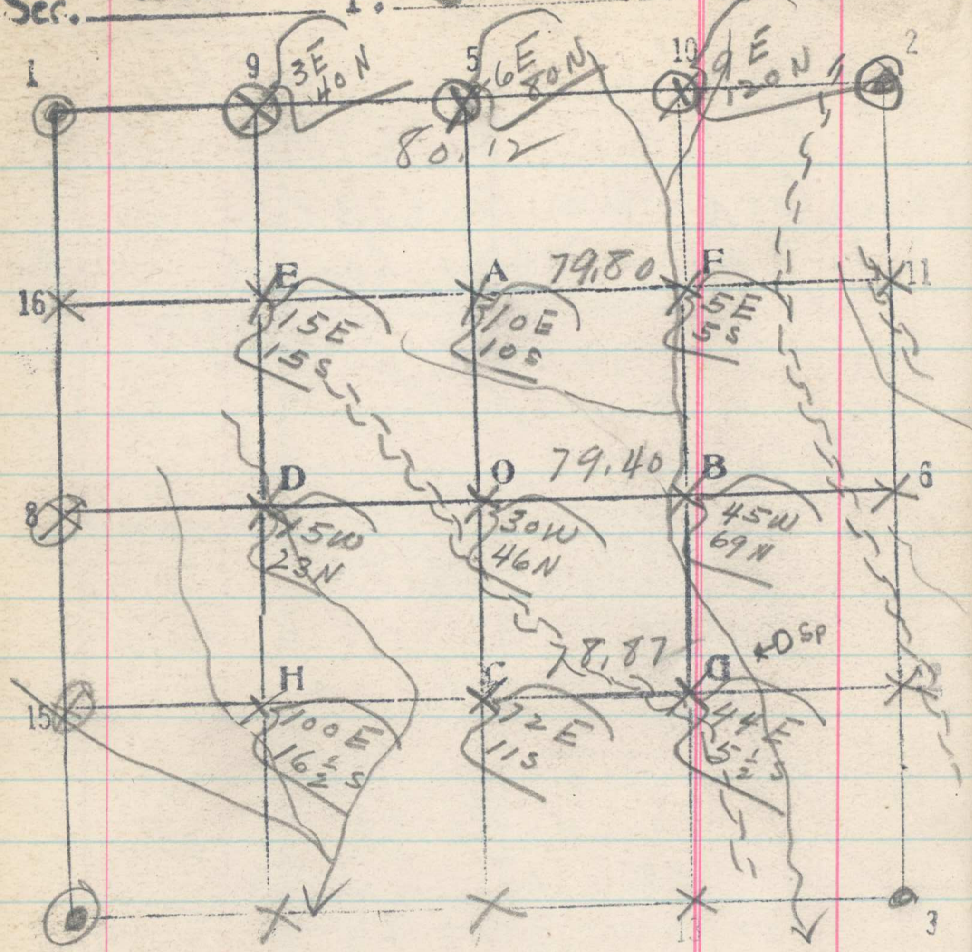Sec. 32 20 T. 3 N R. 36 E