Sec. 41 33 T. 3 N R. 36 E

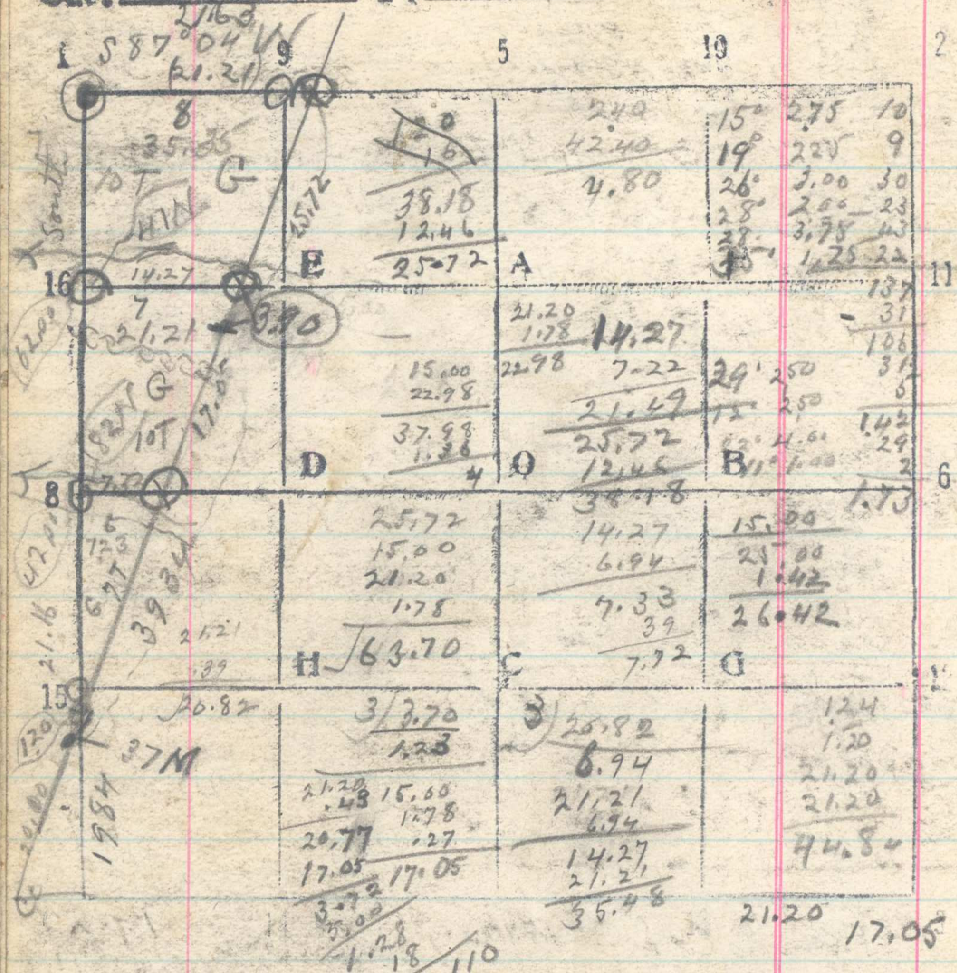

From 36½ M Cor sun S 20° W,

5.00 Ridge N 60° W,

~~15.00 Set stake - Impt for temp CC bet Lots 6 & 7~~ Aug 28

37.98 A point East of cor. 12-S. 32

38.14 C.C. of secs. 32 & 33

39.34 37 M Cor bears W. 8 lks.

~~39.88 To trac, by triangulation~~ Aug. 29

Sept 2 S 50° 17' W by solar bet. secs 32 & 33

1.50	Gulch, W, asc.	28°	276 -35
6.00	Ridge, W, desc.	30°	2.00 -27
17.00	Gulch, W, asc.	29°	1.60 -19
20.	Set 1/16 cor. 11-S. 32	35°	3.50 -60
25.	Ridge N 60° W desc.		1.44
37.00	Gulch N 70° W		1.10
40.	No trace of 1/4 cor.		1.34

58.78 Intersect 1/16 cor. 12-S. 32

58.94 CC of secs 32 & 33

From CC of secs 32 & 33 chain N 20° E on Res bdy

1.16 A point E of 12-S. 32,

21.36 ~~S [illegible] bet lots 6 & 7.~~

-.27 C.C. bet secs. 6 & 7

21.08

From 1/4 cor bet secs 32 & 33 run N 88° 32' E (mean bet N & S bdys of sec. 33)

7.22 Intersect Res Bdy 17.05 chs S 20° W of 36½ M Cor. & set I.P. for CC bet Lots 6 & 7

From 16 S 33 run N 88° 33' E bet Lots 7 & 8

Intersect Res. Bdy 3.90 chs N 20° W of 36½ M Cor & set I.P. for CC bet Lots 7 & 8. Sept 3.