22

Sec. 32 T. 3N R. 36E

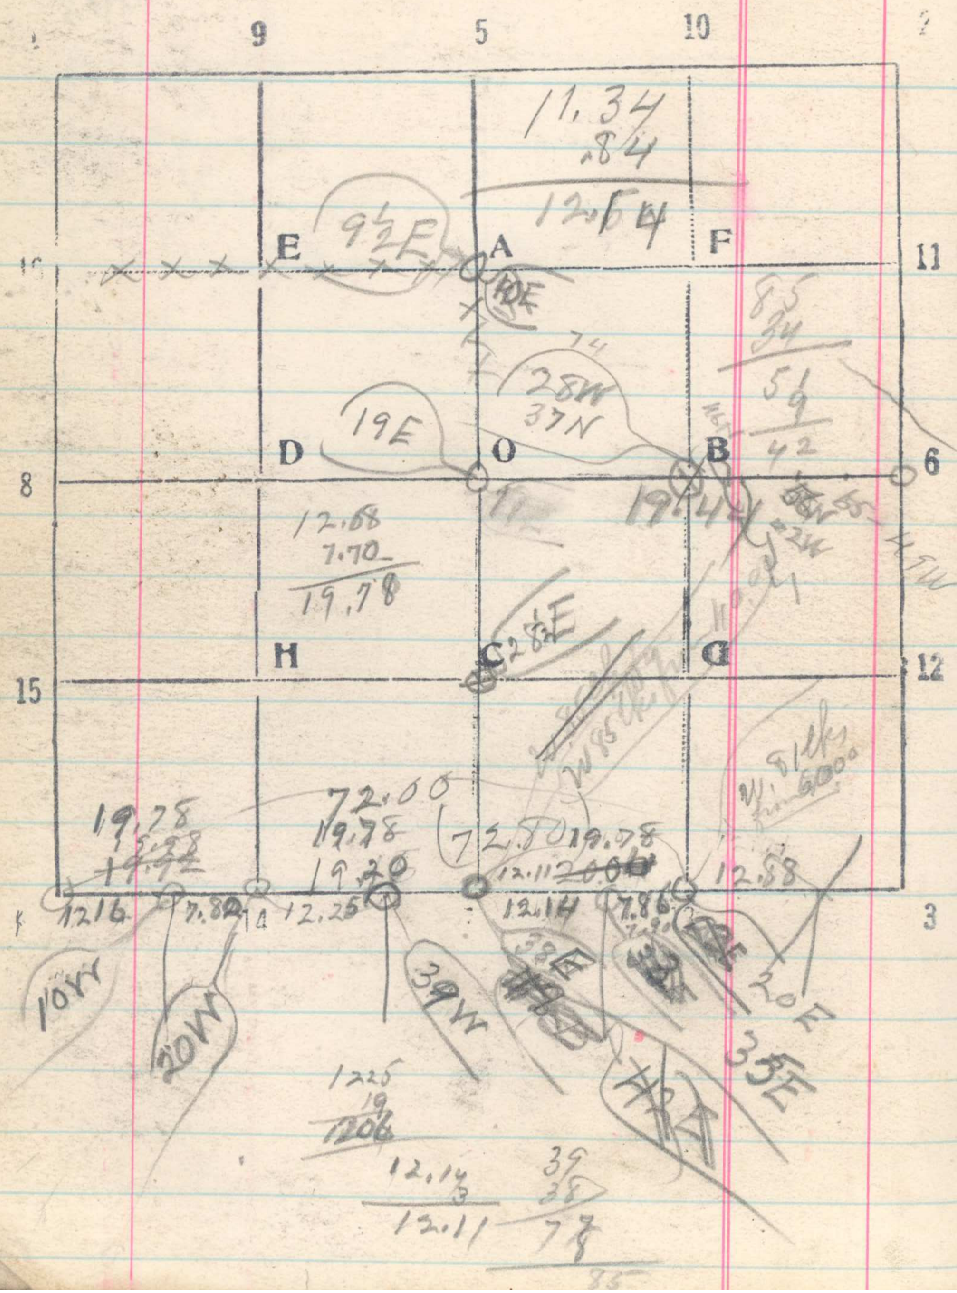

12.08

19.92
19.16
20.04
12.89
~~71.99~~ .25
72.00
19.82
25
12
37
60
2220

38
10
48
60
.78
8.09
15.00
7.02
~~12~~
11
12.20
11
12.09
1216
14
12.02
42
21
63
1288
12.67
.21
17
19.15
.14
47
19.76
58
.50
.80
4.00
2.00
12.80
.13
12.67
28
52
80
31
60
1.860

80 - 72 ch 304

6
8
22
36
78
17
~~200~~
37E
1220
14
12.06
1½
22
12.20
19
12.08
1220
19
12.06
12.20
19
12.06
19.98
19.20
39.18
1915
1992
39.07
1.2.8
~~1.3~~
9
11.52
8
19.5
1920
.20
19.40
38
19.78
9/12.20
1.35
12.20
13.55
22.00
8.45
88
14
66
19.10
19.77
10E
18
21
39E
13
52
1972
1920
19.92
62
50
2/62
31