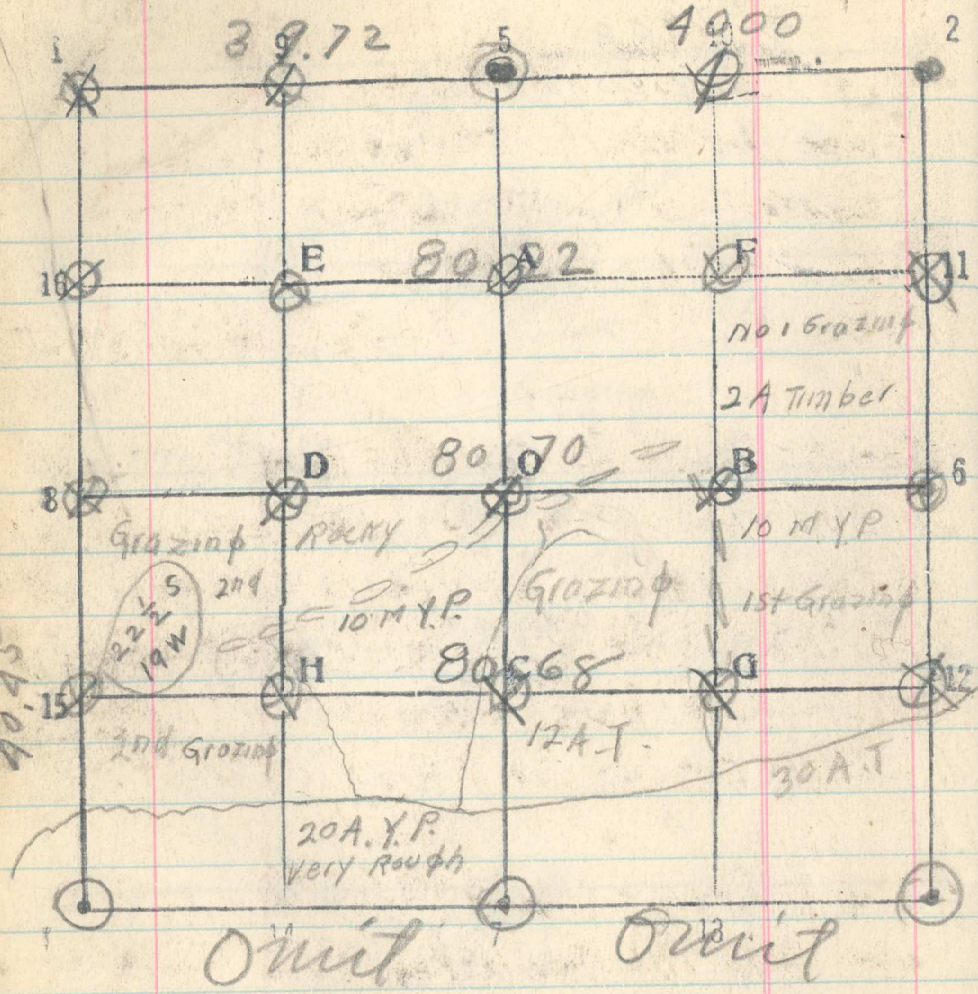

Reshaw from 40 to 60 ch FT

440

West Through Ctr sec 12
over Rolling 1st Grazing land
scattering Yellow Pine timber
Land drains SE
80.70 chs 1/4 Cor bears 149 S

South from 1/4 Cor bet Sects 12 - 11
800 chs spur + Cross over Descend
2000 chs use Base 600 W for Triangulation
3000 chs mc Cor a stake S 70 W
Angle 73° 39' A = 16'21" Cot = 3.40869
2045 - 600
40.45 chs Cor to Sects 12-11-13+14 20.45214 00
bears 38. 1/4 S West

East Through South 1/2 sec 12.
over very Rough Rocky land slopes South towards
mc Kay Creek 20 set stake 10 ch N of Cr
Land to south of Cr 2/3 Pine timber very steep + Rocky
36 chs ravine bears 5°20' W
4068 chs Cor 12 bears 130 lks North