Sec. 2 T. 1 N R. 34 E

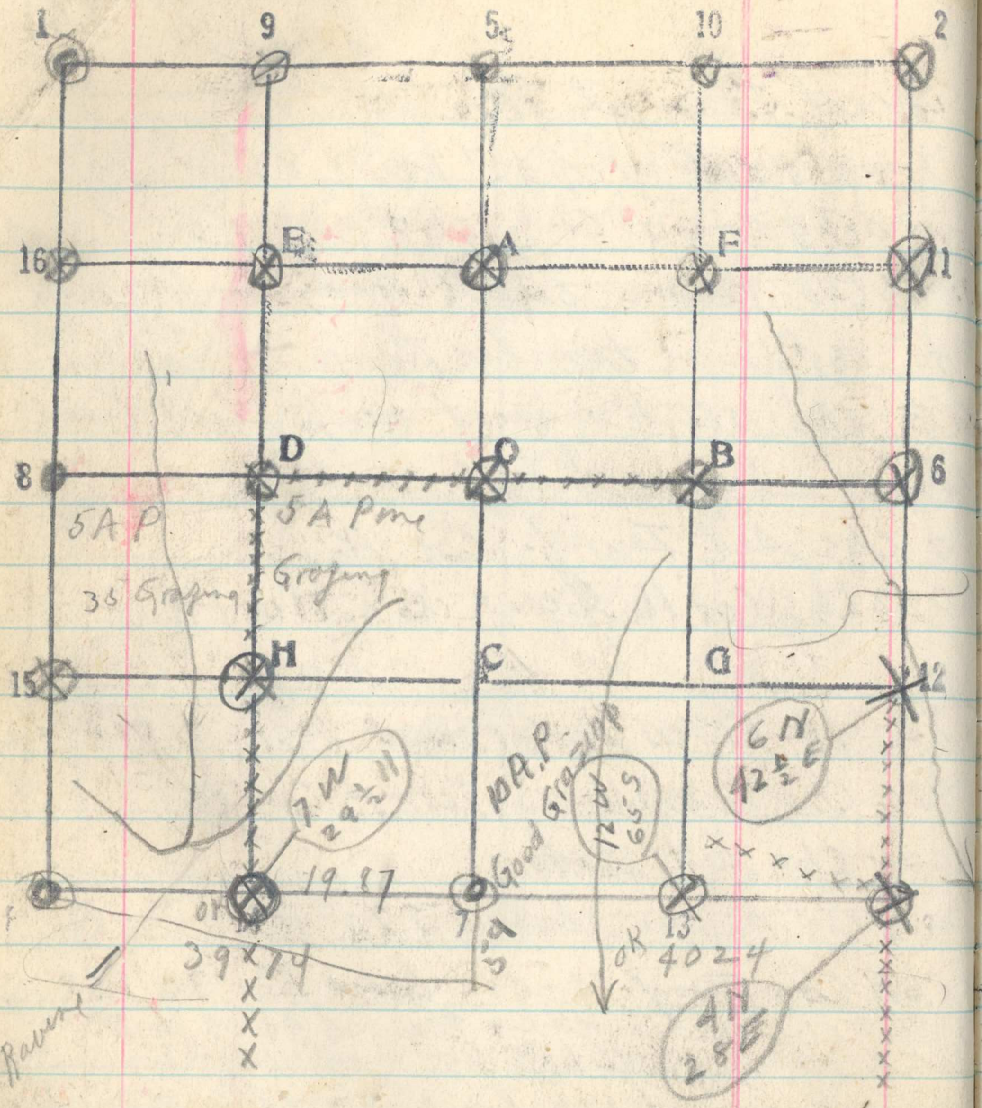

Stake for secct 2-3-10-11 left at 14-52

Wed Nov 19

West bet sectr 2 + 11

2000 Chs set

2750 Chs cross Ravine sheds S 25° E

3500 Chs enter good land draw slopes south

1/3 Timber

4024 Chs 1/4 Cor bearing 130 South

West from 1/4 Cor bet 2 + 11

Retracing old brushed line wheel fell

59 lks south of 1/4 Cor

19.80 Chs to stake marked 20 chs from West

2750 Chs ravine sheds S 45° W

3974 Chs to Cor to sectr

Thursday Nov 20

Line D-14 Sec 2

2000 set stake Temp H

3750 Chs Cross Ravine

4040 chs Cor 14 bearing 2 lks