


Sec. 102 T. 1N R. 34E

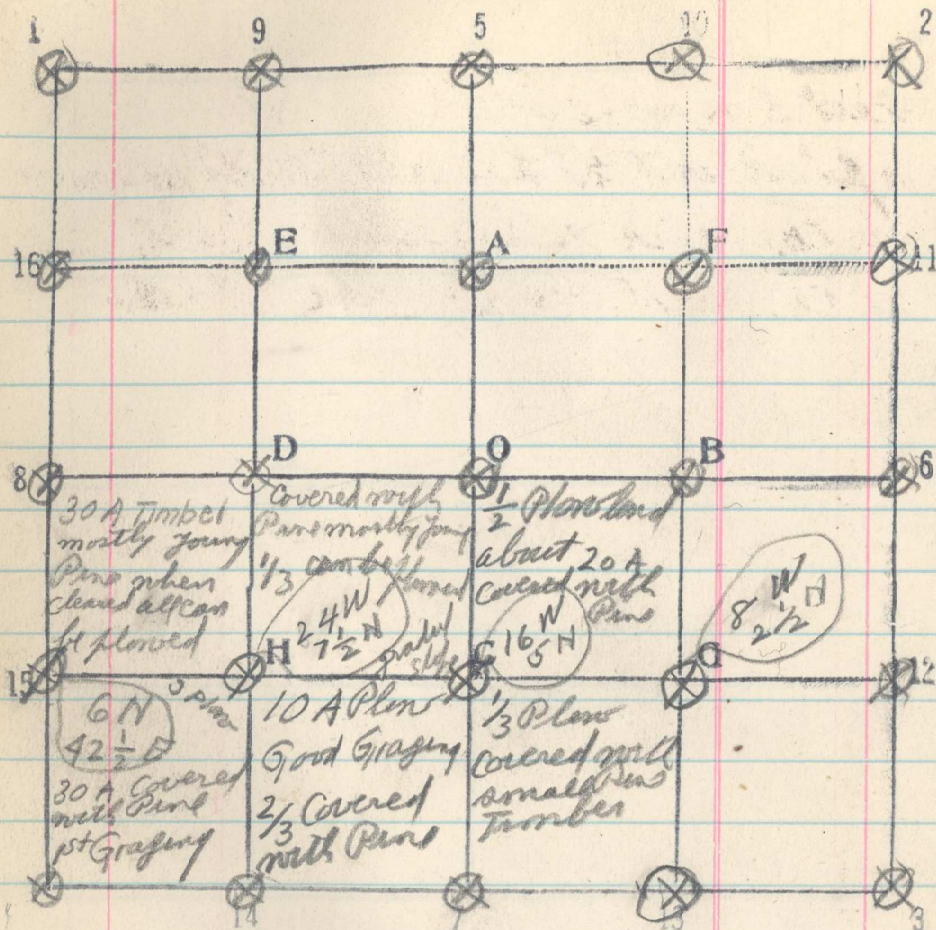

Tuesday Nov 25<sup>th</sup> 1919

447

Went from H - Sec 1

9 finish out the line started by Marrison

76.00 Chs cross Ravine shed South

80.32 Chs on 15 bears 10 lbs North