Sec. 3 T. 1 N R. 3 4 E

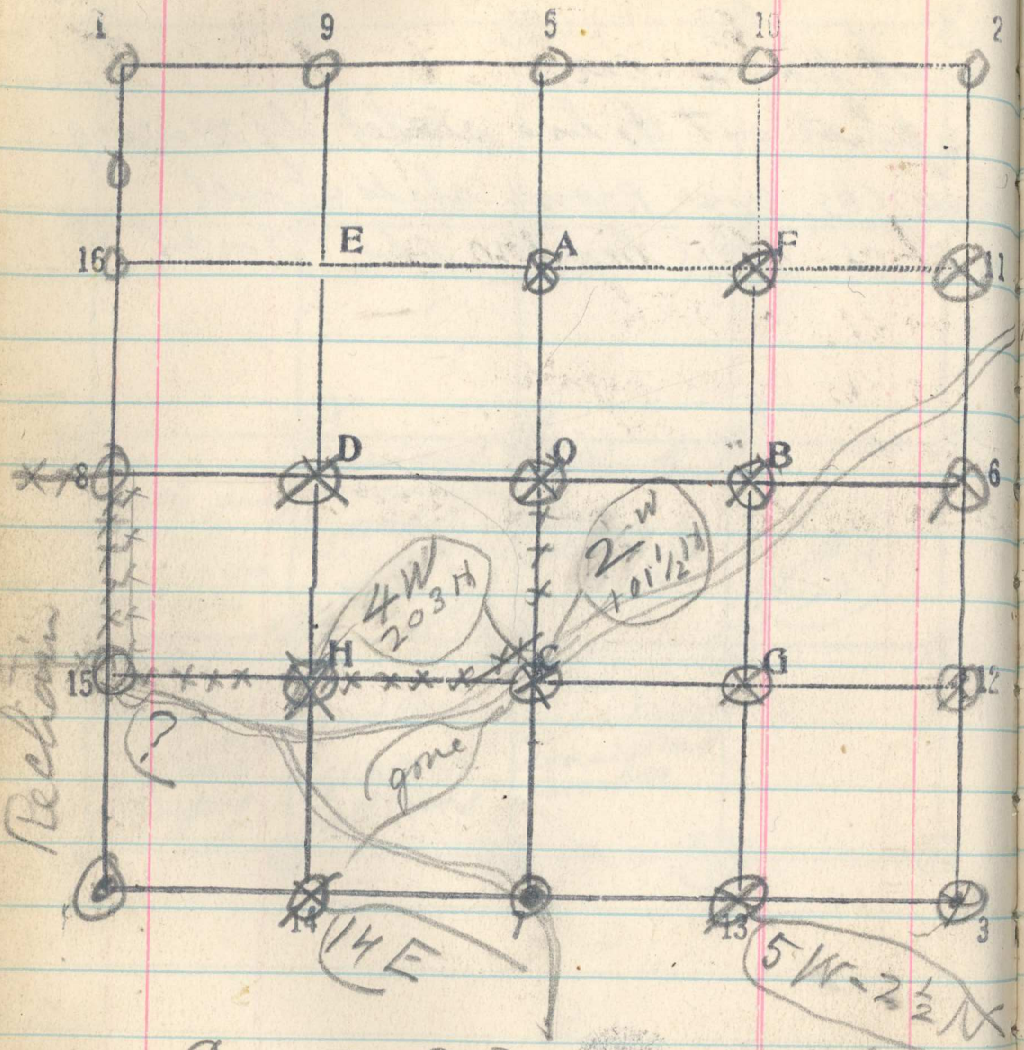

Cor. 15 – S. 3 probably belongs about 20 ft. S. of where the iron post sets at cor. of fence

Run line G-15. 3 443 and Reclains 8-4 to set Cor. 15 midway.

Line G-15 Sec 3

20.00 Chs set Stake
23.00 Chs Road Highway
28.65 Chs " "
60.06 Chs Cor 15 bears 30S N

- 1 1/4
3 / 30S
1