


34
Sec. 6 T. 1 N R. 35 E

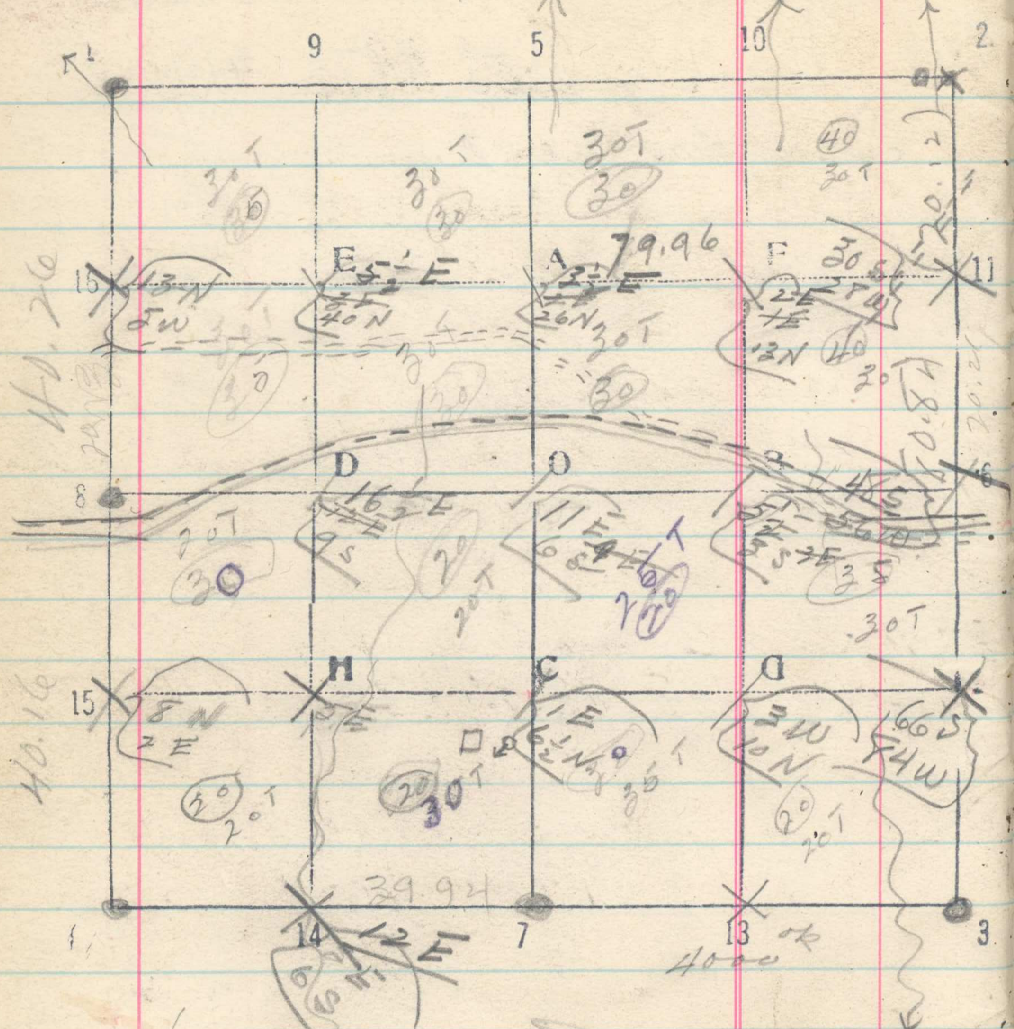

19/3 line 6-8 West thru Center
 let 20 - 40 - 60
 79.84 1/4 cor. bears. S. 12 lks.
 let line 15-12 East thru South half
 29 - 40 - 16
 79.93 1/16 cor. 12 bears N 52 lks

10/3 line 2-3 South between 5 & 6
 let 20 - 40 - 60
 80.84 Old sec. cor. bears W. 112 lks
 10/3 line 3-7 West between 6 & 7
 let 20
 5 Prairie Sheds South
 40 old 1/4 cor. reestablished from B. T. on line
 10/4 line 7-4 West from 1/4 cor. between 6 & 7
 let 20 in bottom of ravine
 39.94 1/4 cor. bears. S. 12 lks.
 10/4-11 line 4-8 North between 6 & 7
 let 20 / 39 Highway E.-W
 40.16 1/4 cor. bears. East 4 lks.
 10/11 line 8-1 North from 1/4 cor. between 6 & 7
 13 Road E.-W
 19.60 Lump 1/16 cor from E bears. W. 9 lks.
 let 20
 240.76 Township cor. bears. W. 10 lks
 line 7-16 West thru North half
 let 20 - 40 - 60 - 80
 79.96 1/16 cor 16 bears N 52 lks