


36

Sec. 4

T. 1 N R. 35 E

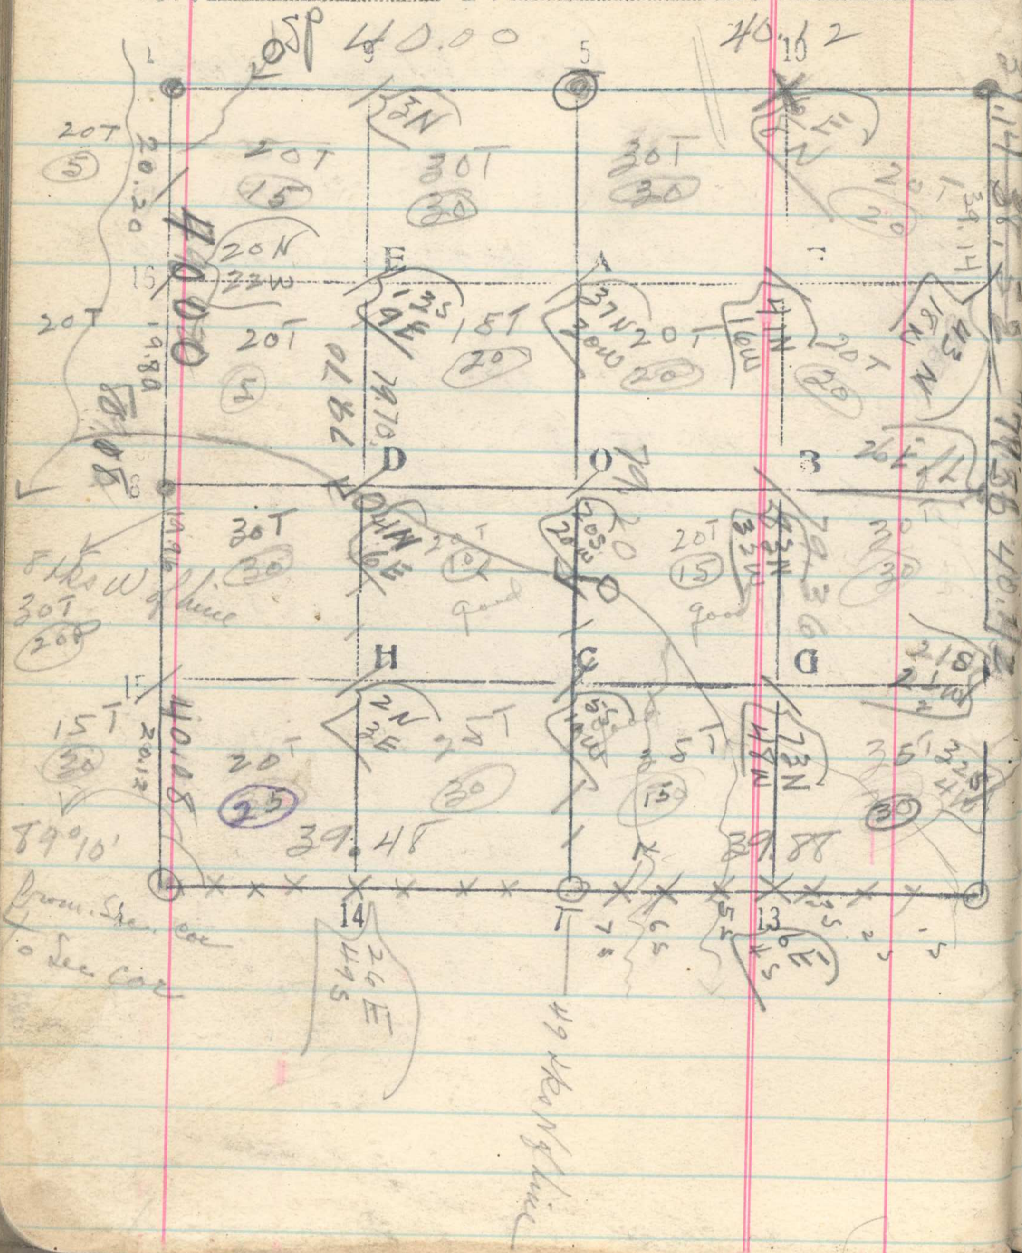

554

- 10/6 line 1-5 East between 5+8
 Let 20
 40 1/4 Cor. bears N 6 W
 10/6 line 5-2 East from 1/4 cor. between 5+8
 Let 20
 14 Road N 30 W - S 30 E
 40.12 Sec. cor. 4-5-8-9 bears N 16 W
 10/6 line 2-6 South between 8+9
 Let 20
 20 Highway N 30 W - S 30 E / 25 Road N 30 W - S 30 E
 39.14 1/4 cor. bears W. 36 W
 10/6.7 line 6-3 South from 1/4 cor. between 8+9
 Let 20 - 30
 39.58 Sec. cor. 8+9 bears W 5 W
 10/7 line 3-7 West on South bdy of Sec. 8.
 Let 5-10-15-20-25-30-35
 25 Ravine sheds North / 33 Ravine North
 39.87 1/4 Cor bears S. 8 W
 10/7.8 line 7-4 West from 1/4 cor. on South bdy of 8.
 Let 5-10-15-20-25-30-35
 39.48 Sec. cor bears S. 25 W
 Run back East on true line