


37

Sec. 8 T. 2N R. 35E

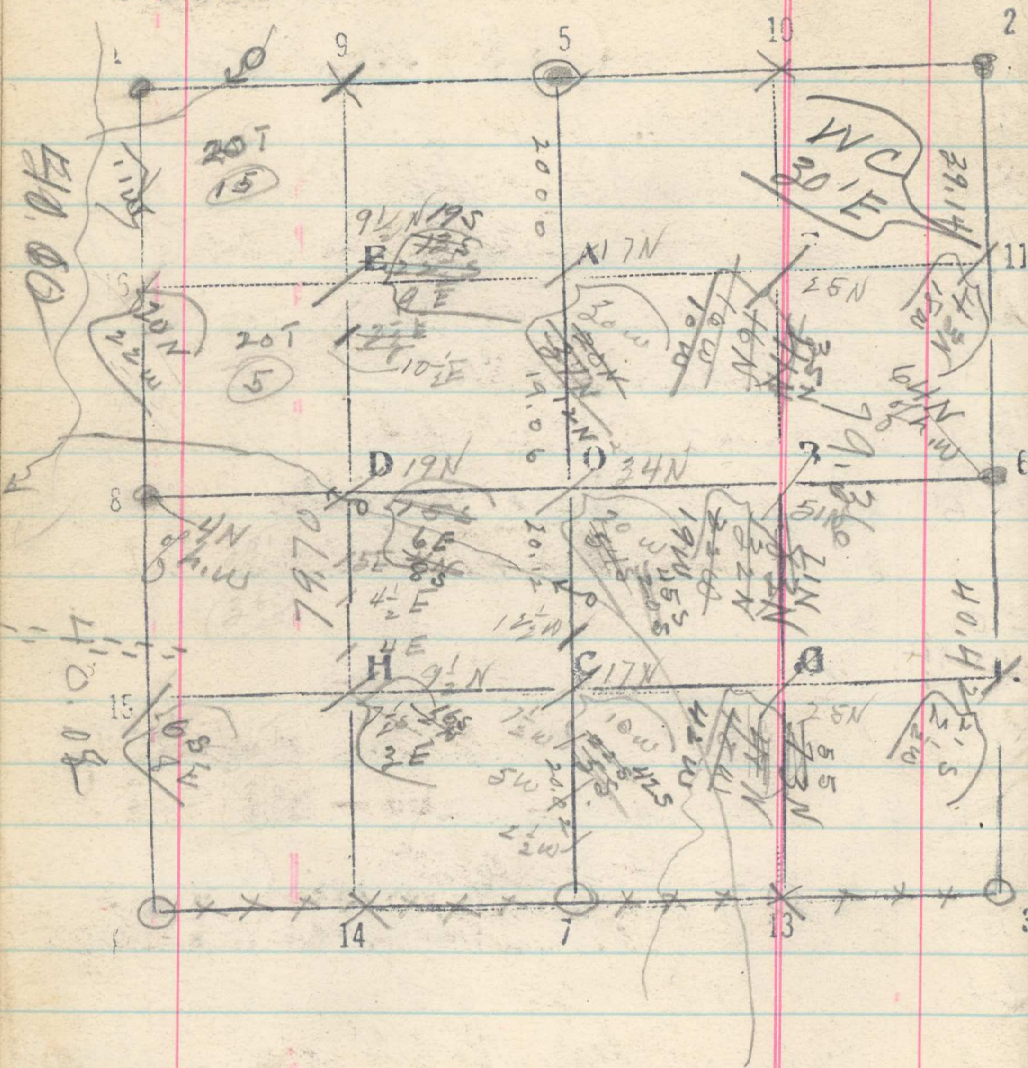

10/8 Line 7-5 North thru center 555

Let 5-10-15-20-25-40-60

30 Ravine Sheds NW

79.20 1/4 cor. bears. W. 40 pks.

10/9 Line 1-8 South between 7+8

Let 10-20

30 Ravine Sheds W.

35 Ravine Sheds west

40.00 old 1/4 cor. bears. W. 44 pks.

10/9 Line 8-4 South from 1/4 cor. between 7+8

Let 20

40.70⁰⁸ Sec. cor. bears. E 16 pks.

0/9 Line 14-9 North thru west half.

Let 20-25-30-35-40-55-60

39 Ravine Sheds west

79.70 1/16 cor. 9 bears. E 12 pks.

10/8-10 Line 10-13. South thru East half.

Let 20-40-60

79.36 1/16 cor 13 bears. W. 64 pks.