38

Sec. 9 T. 1 N R. 35 E

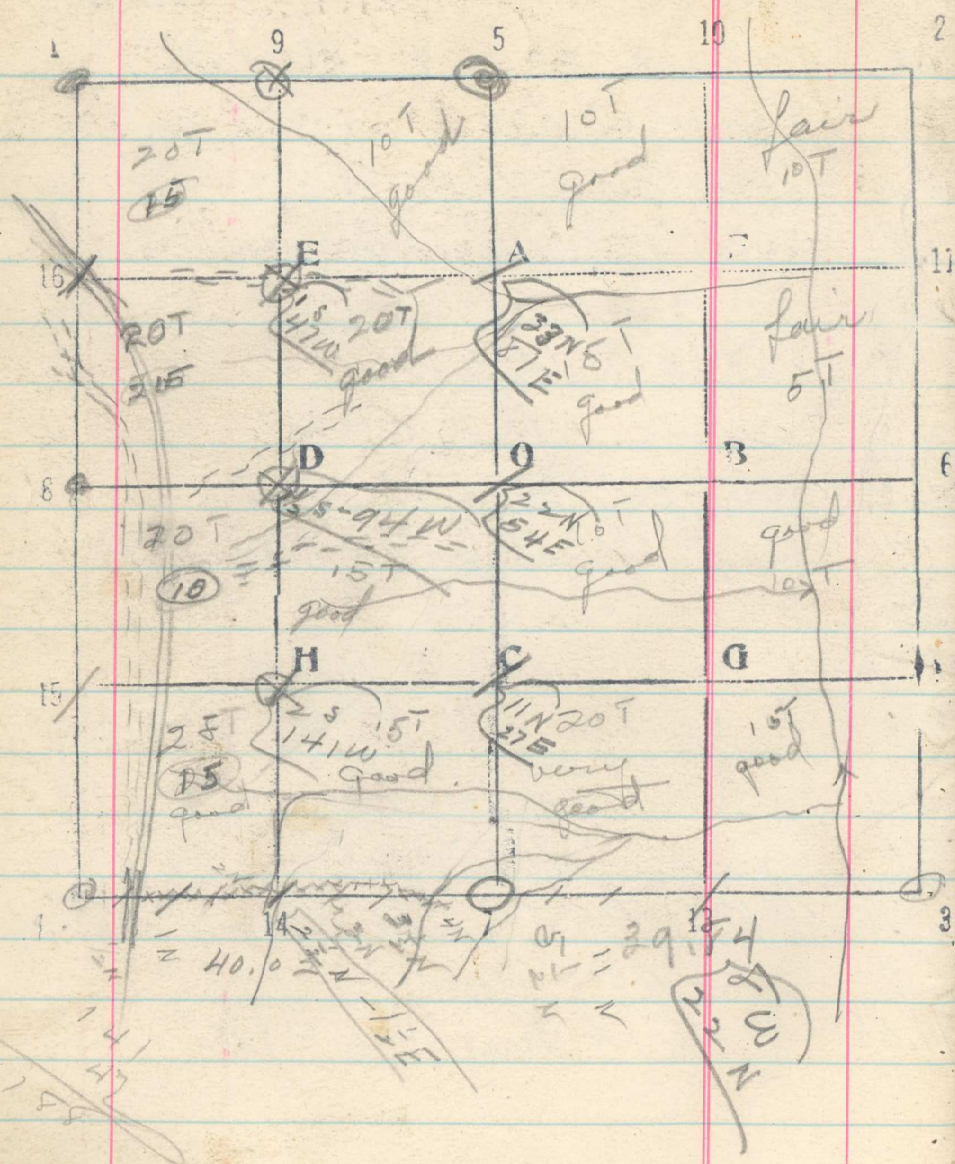

10/22 Line 4-7 East between 9 & 16

Set 5-10-15-20-25-30-35

5 Road N-S. / 20 Ravine Sticks. N 20 E

40.03 1/4 Cor. bears N 5 lks.

10/20 Line 7-3 East from 1/4 Cor. between 9 & 16

Set 5-10-20

39.84 Sec. Cor. 9-10-15-16 bears N 44 lks.

11/6 Line 9-14 South through Hoff.

Set 20-40-60

7 Ravine Sticks & 70 E / 30 Ravine Sticks E

45 Ravine Sticks N E / 63 Ravine

40.03 1/16 Cor. 14 bears W 158 lks.

11/24 Line 7-5 North thru Center

Set 20-40-60

80.44 1/4 Cor. of 4 & 9 bears E 108 lks