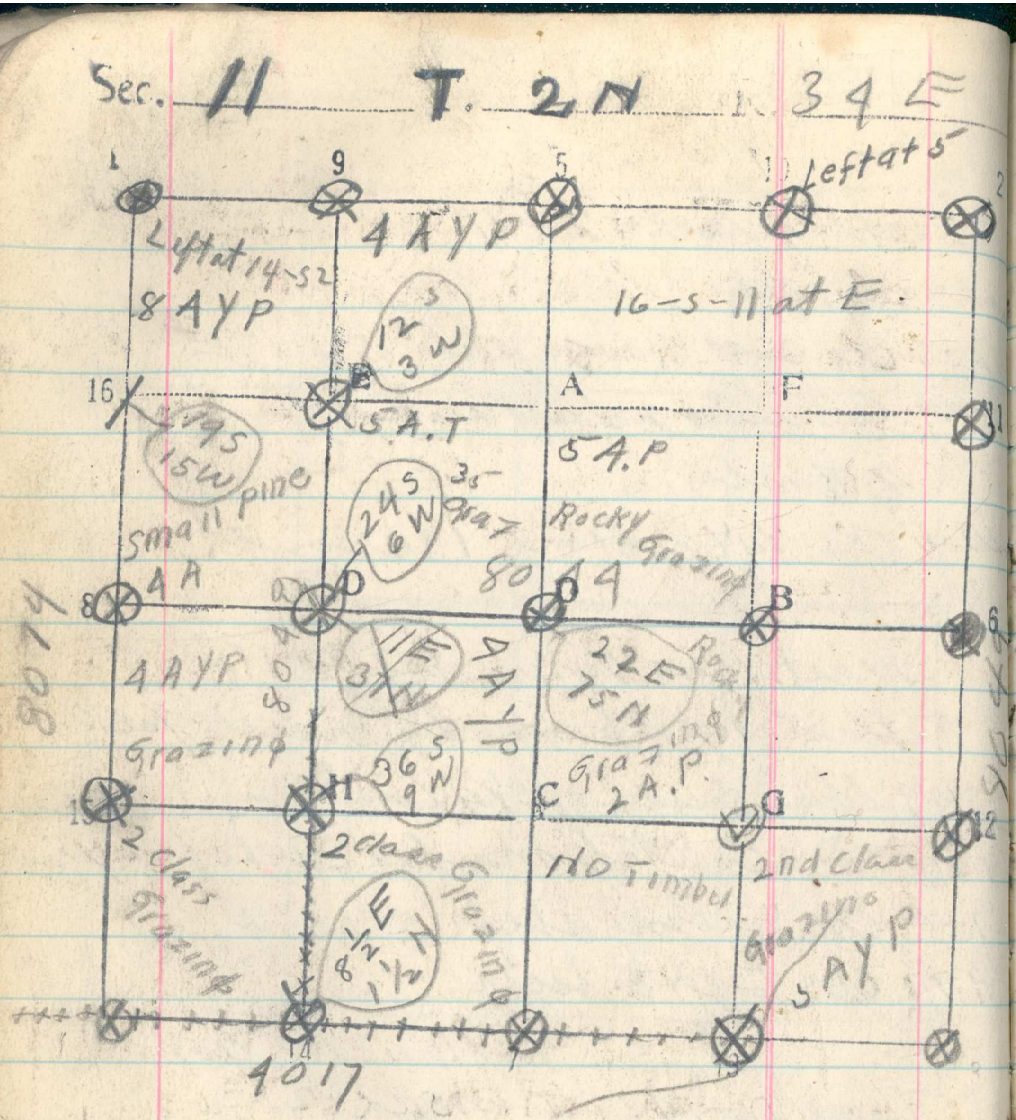

443

Line 9-14

South from 9-5-11 South
6 Cor Chs bears brush + intis flat
20 00 Chs set Temp E-5-11 20 chs E of it
23 50 Chs small ravine sheds S 50 W
40 00 Chs set Temp D-11
60 00 Chs set Temp H
80 Chs set Temp 14
80 48 Chs Cor 14 bears 12 chs West
The fence Corners 6 chs N + 3 chs West

East on South line sec 11 from cor to
secto 10-11-14-15
40.17 Chs 1/4 Cor bet 11 + 14 bears 3 lks North

From 1/4 Cor to secto 11+14 East on
South bdy sec 11 following wire fence
2000 Chs set stake 2075 Chs NW Kay Cr sheds S 70 W
3987 Chs Cor 3 sec 11 bears