


2

15 T. 2 R. 34 E

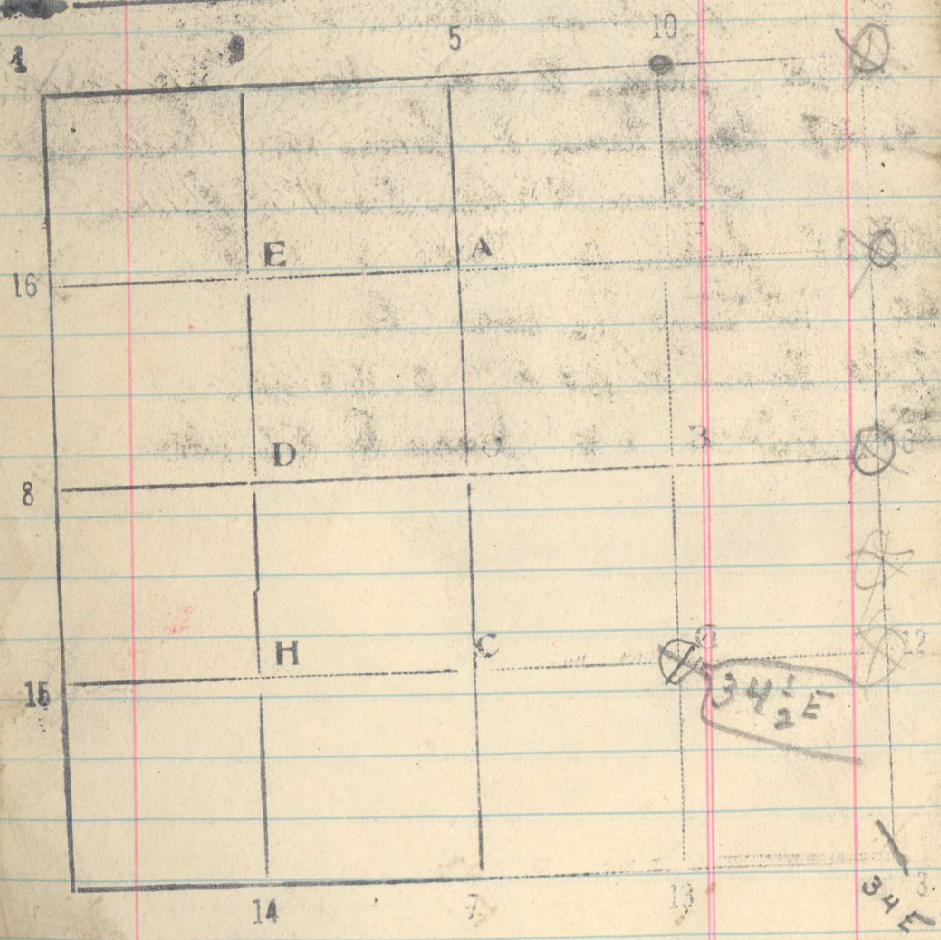

3/20

South from East hall line 10-13

Run up along side of lane
 20.25 fence E + W. Lane goes 25 W E
 41.47 lane turns E. Fence on West side
 of lane 44 W. East of line

58.25 fence N 70 W S. 70 E

60 set temp 1/2 cor. G.

71.40 fence N 65 E - S. 60 W.

80 1/2 cor 13 mark E 46 W.

34 E