


5
Reset corner 8/10/0 B 15+4

See preceding page

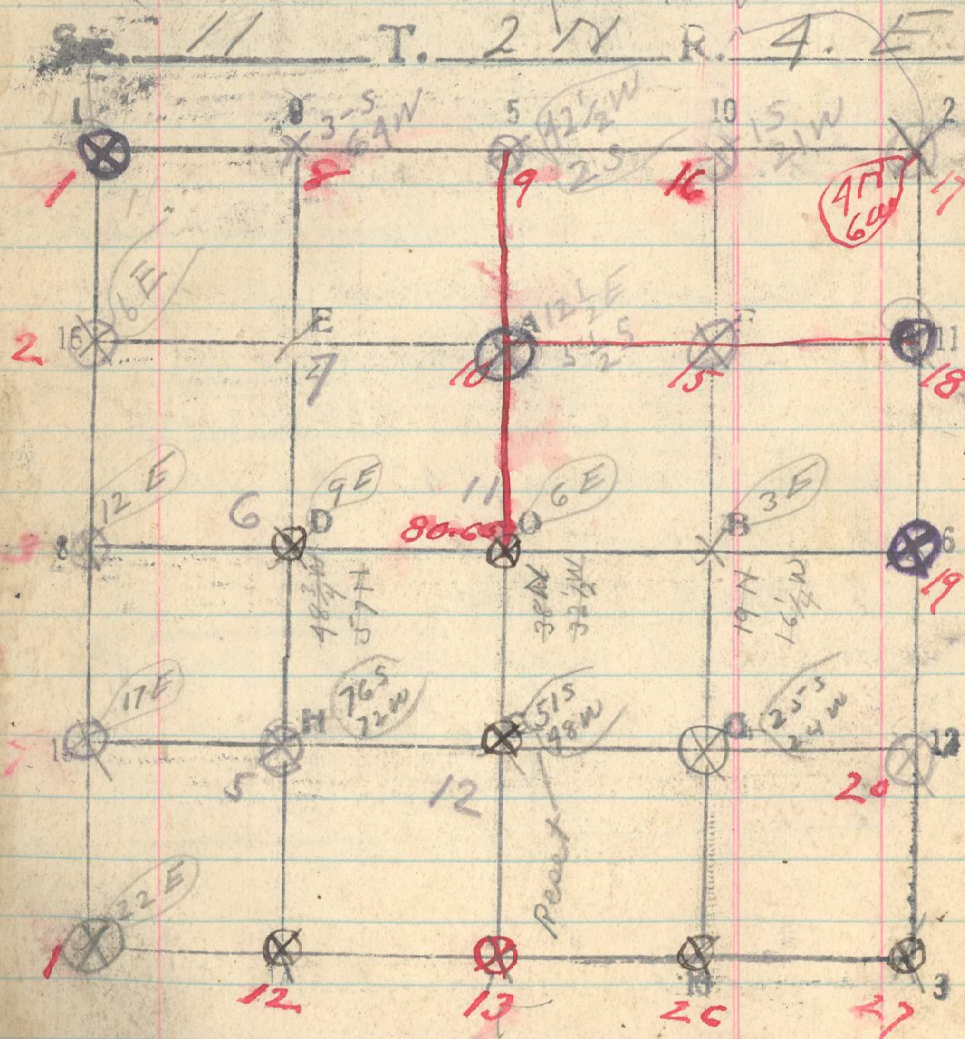

Friday March 7th 1919

481

West through the Center of Sec 11

20

40

60

80.65 Ch cor 8 bears 76 lbs North

March 19

West bet sects 2+11 line 2-1

20-40-60 Ch set stakes

80.85 Ch cor 1 bears 4 lbs South

Line 5-0 20

40.11 Ch cor 0 bears 2.5 E

Line A-11

20 set stake

40.25 Ch cor 11

Continued on preceding page

15
16
17
18
19
20