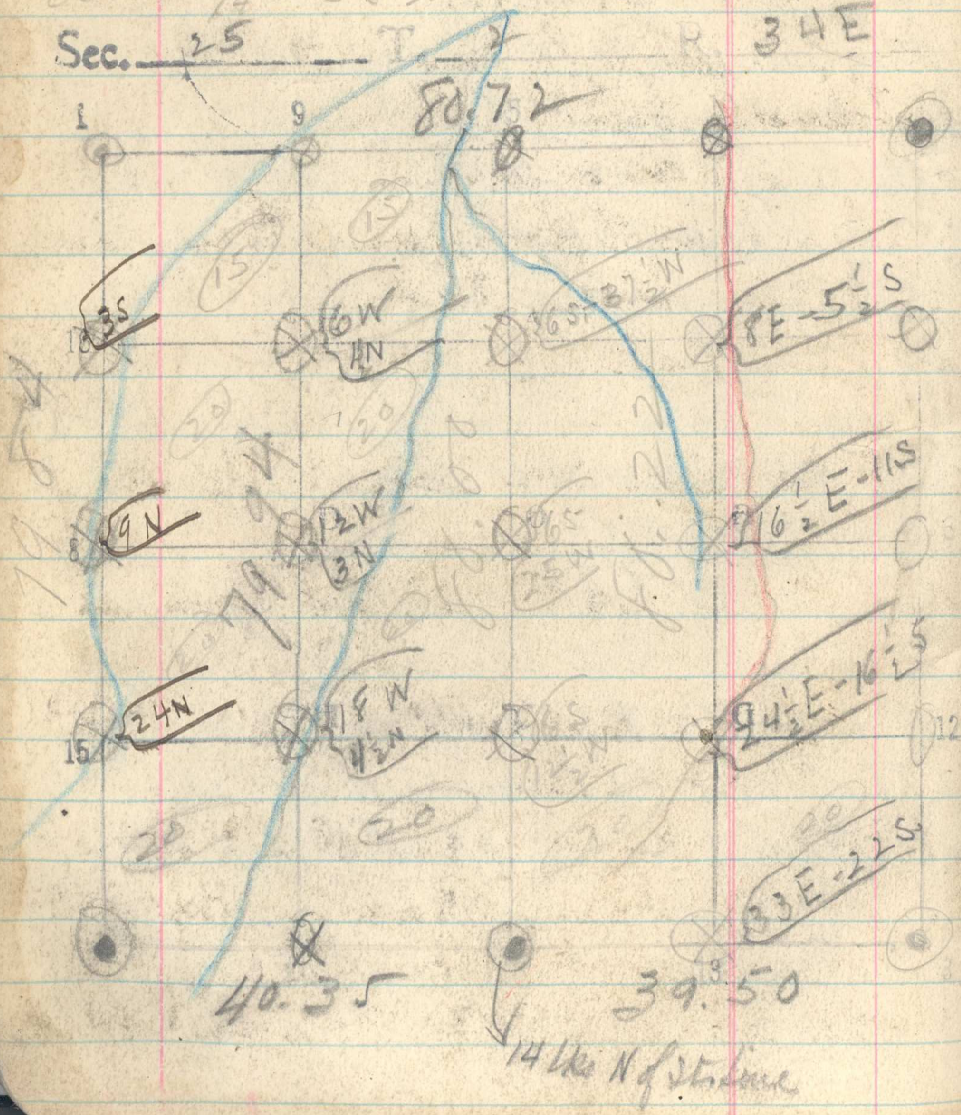

13 [illegible] Line 7-5

[illegible] 20.00 [illegible] Cor Cor on Line

40.00 Set Imp 1/16 cor 6

60.00 Set Imp 1/16 cor 7

80.00 1/4 Cor. S bears W 50 lks

4/5 South Thru East half of 25. Line 10-13.

Set 20-40-60

489

59 Road NE.-SW.

80. Set Imp 1/16 cor. 13.

Thence West

19.42 Old 1/4 cor on Line

Distance West from 1/4 cor between Sec.

25 & 36. Line 7-4

20 Set Stake

40.35 Old section cor bears N. 11a Lks.

Old corner 150 E - 27 N of Imp cor.

4/19 South Thru West half. Line 9-14

Set 20-40-60

79.94 1/16 cor 14 bears W 24 Lks.

4/9 Exit between 25 & 26. Line 7-3

19.42 Imp 1/16 cor. from N. on Line

39.50 Sec. cor 25-35-30-31 bears S. 44 Lks.