Sec. 27

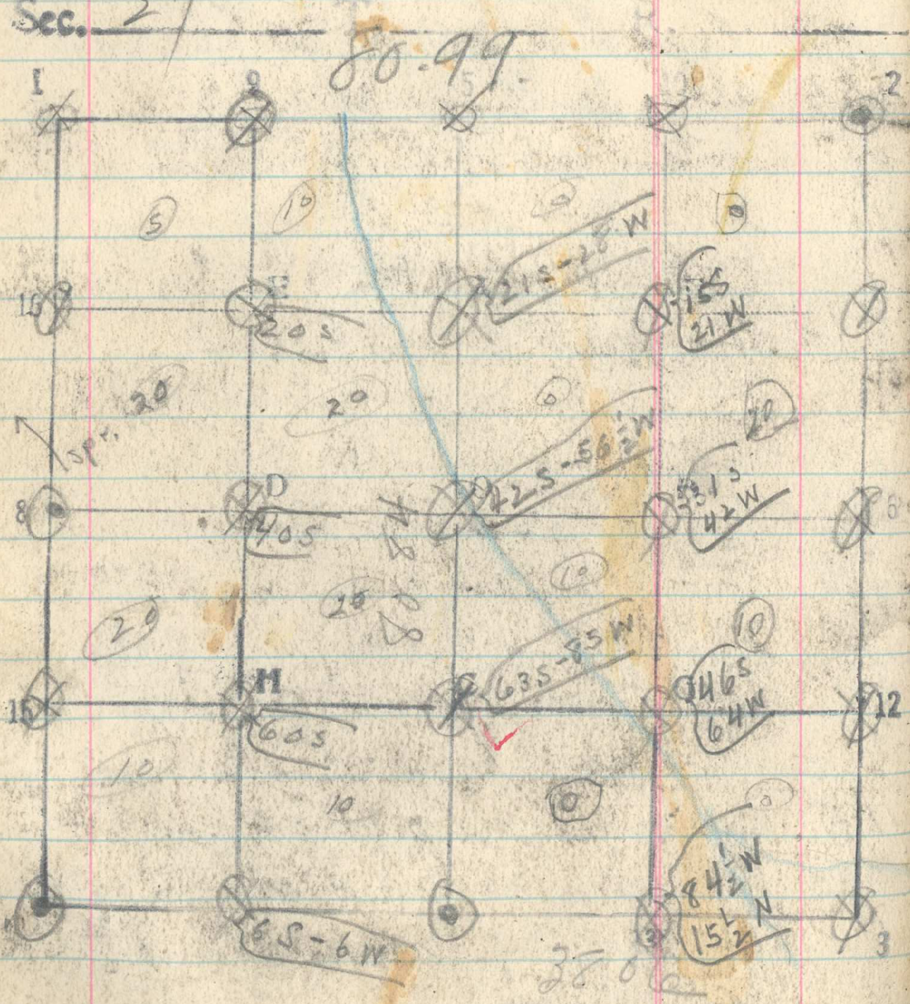

South thru center of 27 line 5-7
Set 20 - 40 - 60
37 Creek 10 lks N 30W
80.84 old ¼ cor bears West 11 3 lks ..
4/7 South thru West half line 9-14
Set 20 - 40 - 60
63 creek 5 lks wide N.W. | Enter pine thicket
80.74 old temp 1/16 cor 14 bears E. 11 lks
4/7 East between 27 & 34 Rerun line 4-7.
70.06 old temp 1/16 cor bears N. 16 lks.
40.00 ¼ cor. 7 bears N 20 lks.
4/8 South thru East half line 10-13.
Set 20 - 40 - 60
9.00 Creek 5 lks wide slides N.W.
80.00 Set temp 1/16 cor 13
4/8 West between 27 & 34 line 3-7
8.00 Creek 10 lks slides N.
16.87 80. Ch point from N bears N 77 lks
16.87 Set stake
38.06 ¼ cor 7 on line