


17

Sec. 33 T. 2N R. 24E

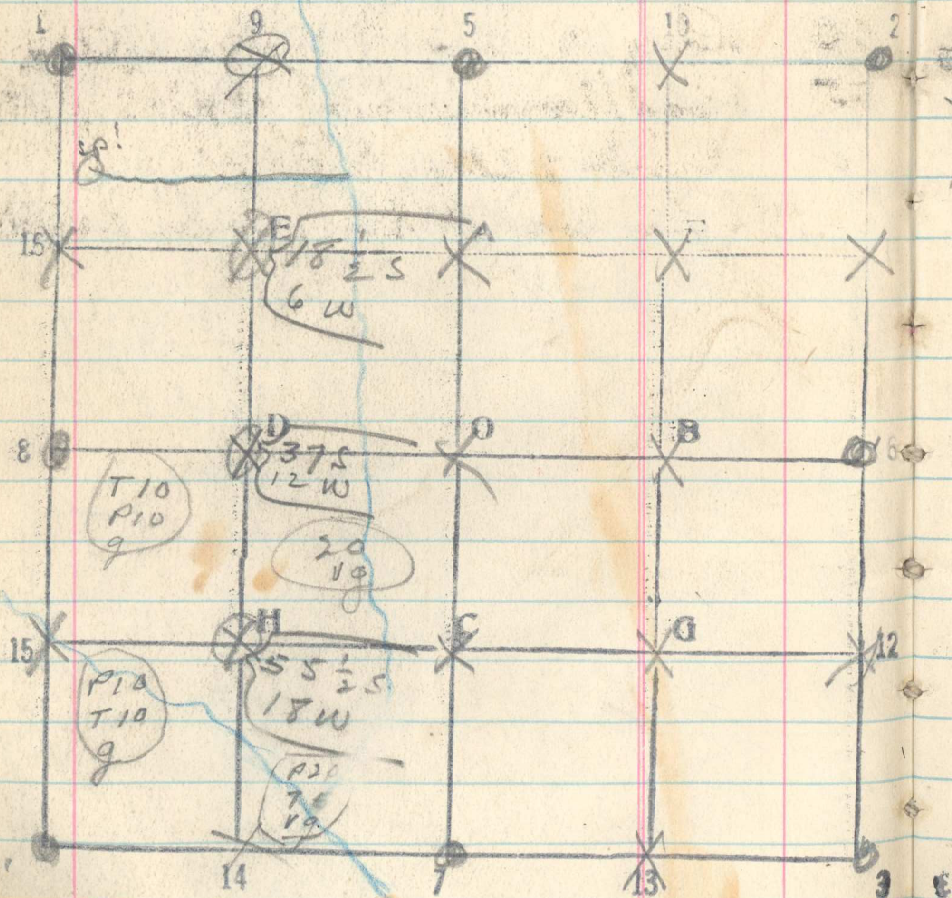

4/16

493

9-14 Run south thru West half.
Set 20-40-60

15 Small creek from top side E.

50 Road N.W. - S.E. (Main Road)

55 Road (branch up creek) N.W-S 200

70 Creek 2 like N 30 W.

80.74 1/16 Cor 14 bears west 24 like