20

Sec. 36 T. 2 N R. 3 4 E

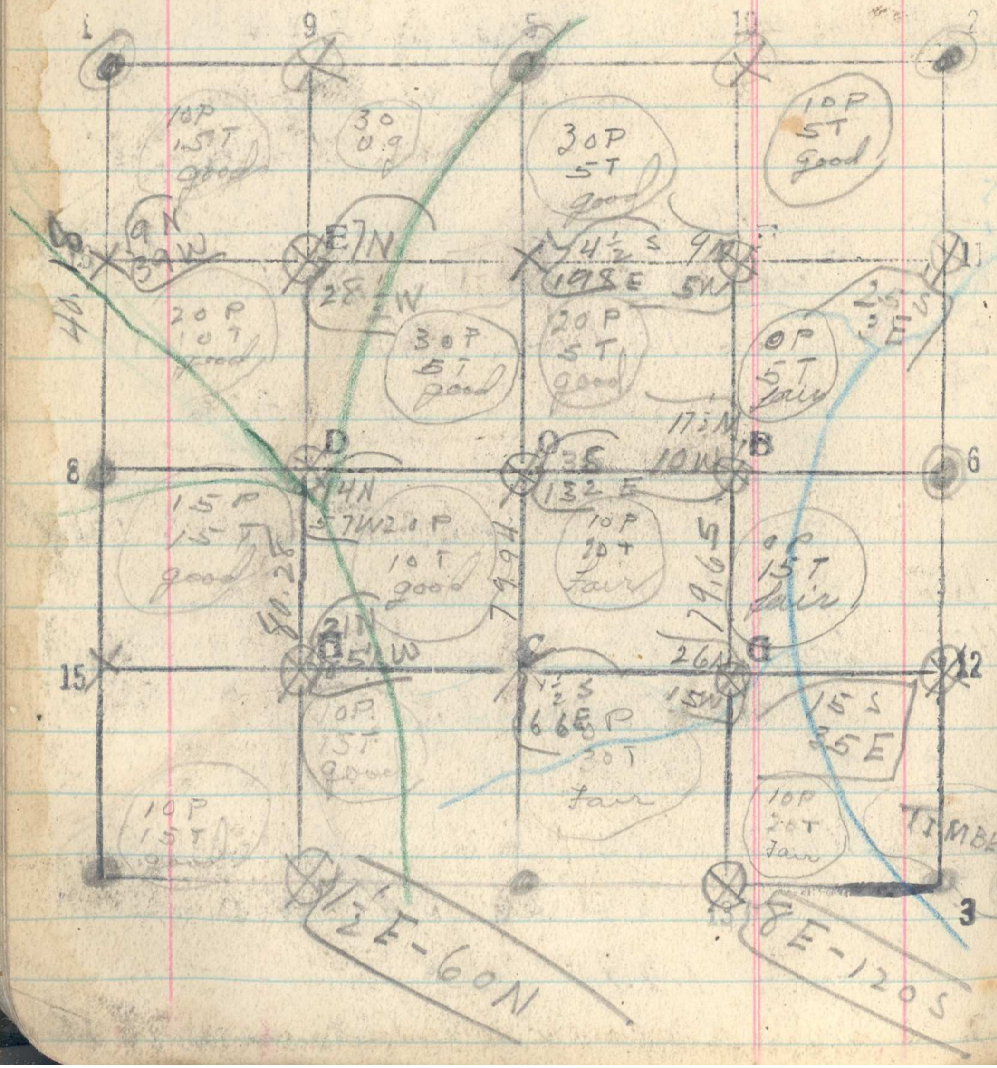

4/21 Line 10-13. South thru East half
Set 20-40-60.
25 Creek 2 lks. Shds E
61 Creek 5 lks. Shds. N 45 E
79.65 1/16 Cor 13 bears W. 20 lks.
4/21 Line 7-5 North thru Center.
Set 20-40-60
10 Creek 5 lks N 45 E
20 Creek 2 lks E.
79.94 1/4 Cor 5 bears E 26 4 lks.

4/22 Line 9-14 South thru West half
Set 20-40-60
43 Road NW N. 30 E. (Junction of Roads 2 ch East of line)
44 Road (or Trail) W-S. 20 E
75 Creek 2 lk. Shds N 70 E.
80.28 1/16 Cor 14 bears W 114 lks.
4/22 Line 8-1 North between 26 & 35 thru 1/4 Cor.
Set 20
15 Road NW-S. 70 E.
40.18 Sec Cor 25-26-35-36 bears W. 78 lks