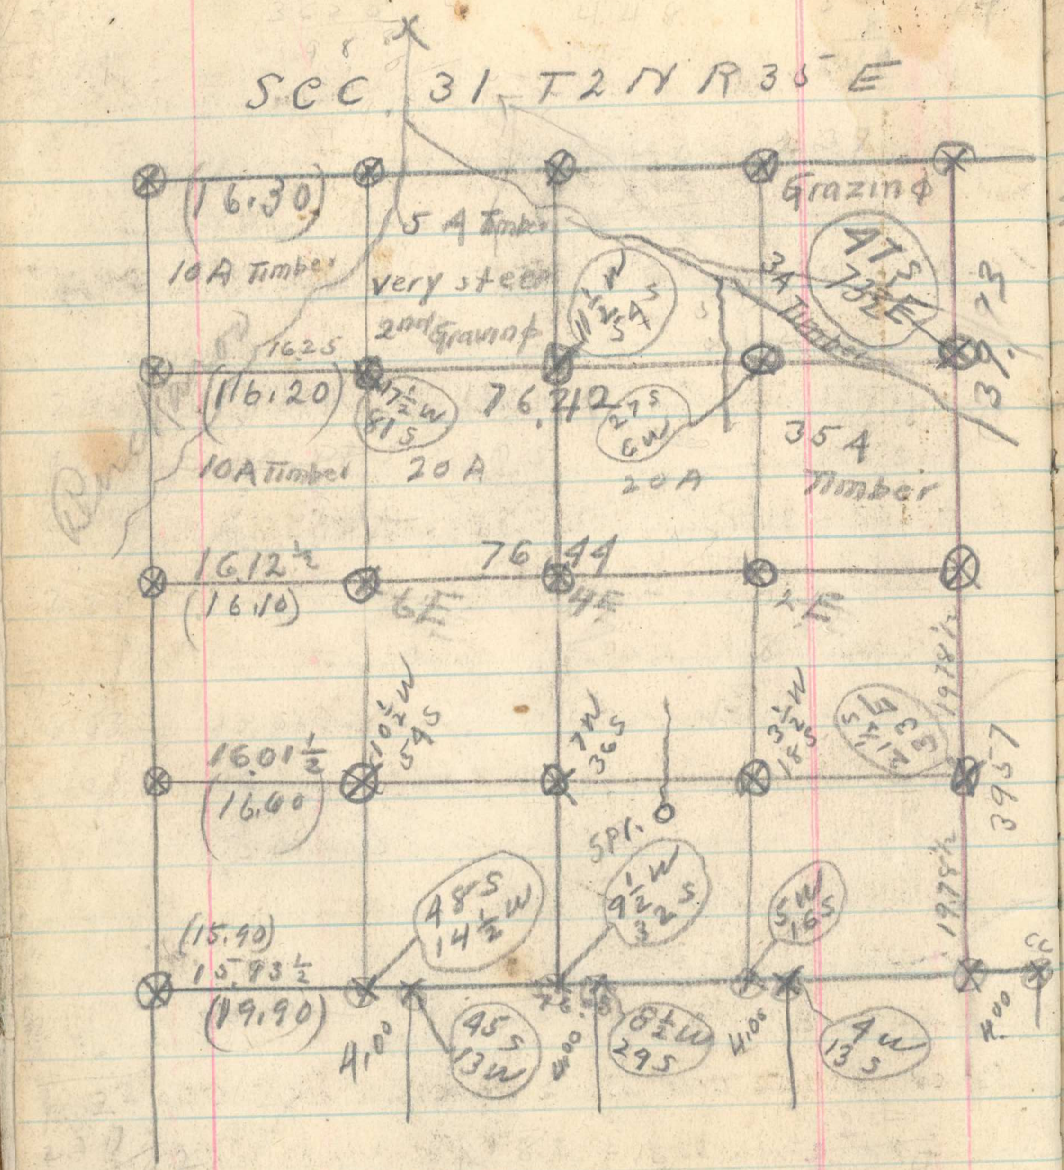

Corrections = .8 South to each chain

" " .24 West " " "

Monday Aug 20th 1919 1

T 431

North Bet Sects 31 + 32 T2N R35E

20-40-60 Chs set stakes

39.57 Chs ¼ Cor bears 60 lks East

48.50 Chs Cross Deep Ravine sheds NW

79.50 Chs Cor to sects 29-30-31+32 Cor bears S1E

North Bet Sects 29 + 30 T2N R35E

20-40-60

55.00 Chs Deep Ravine sheds N 65° W

78.41 Chs Cor to sections 19-20-29+30

bears 93 lks West This Cor is Mound

of stone 10 x 12 x 4 5 notches on East

+ 2 notches on South faces

Twesday Aug 21st 1919

West on TP Line South Side Sec 31

16-20-36-40

36.20 chs an old stake marked ¼ S bears

24 lks South a 22" Fir bears S 10° E 31 lks 12 lks

76.08 Chs the SW Cor TP Bears 60 lks South