Sec. 30 T. 2N R. 35E

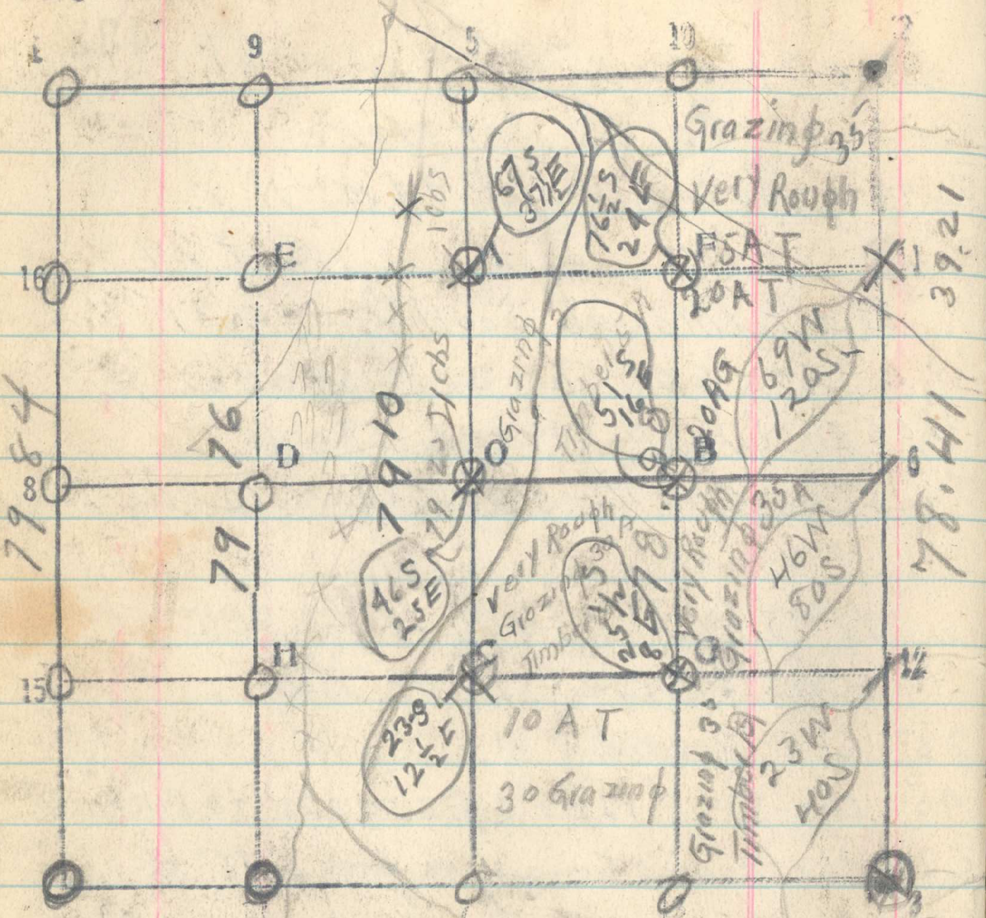

7841
7898
739

2) 79 10
39 55
19 77

3

North Through East ½ Sec 30

11.93 Chs base 300 Δ 9°39' = .1764

29.57 Chs to Pt on Ridge

20-40-60 chs set stakes

68.00 Chs Cross deep Ravine sheds W

78.98 Chs Cor 10-5-30 bears 32 lks East

North Through Ctr Sec 30

6.00 chs cross over spur slopes 25°

West to Buckaroo Cr

6.80 Descend

27 chs cross Buckaroo Cr sheds N 20°E

13.62 Chs Triangulate Base 3.45 Chs

33.36 5°44' Cot = 9.96007

46.98 Chs to pt on steep side Hill 6 chs West of Buckaroo

3.40
4980036
3984028
2988621
34.3622410

59.00 Chs Ridge N 65 W & S 65 E

60.00 Chs the Intersection of Buckaroo Cr + a Creek coming in from the East bears N 43°E 10 Chs

79.10 Chs ¼ Cor bears 50 lks East

Creek sheding N 70°W bears 1 ch N