21

Sec. 18 2N 3 5E

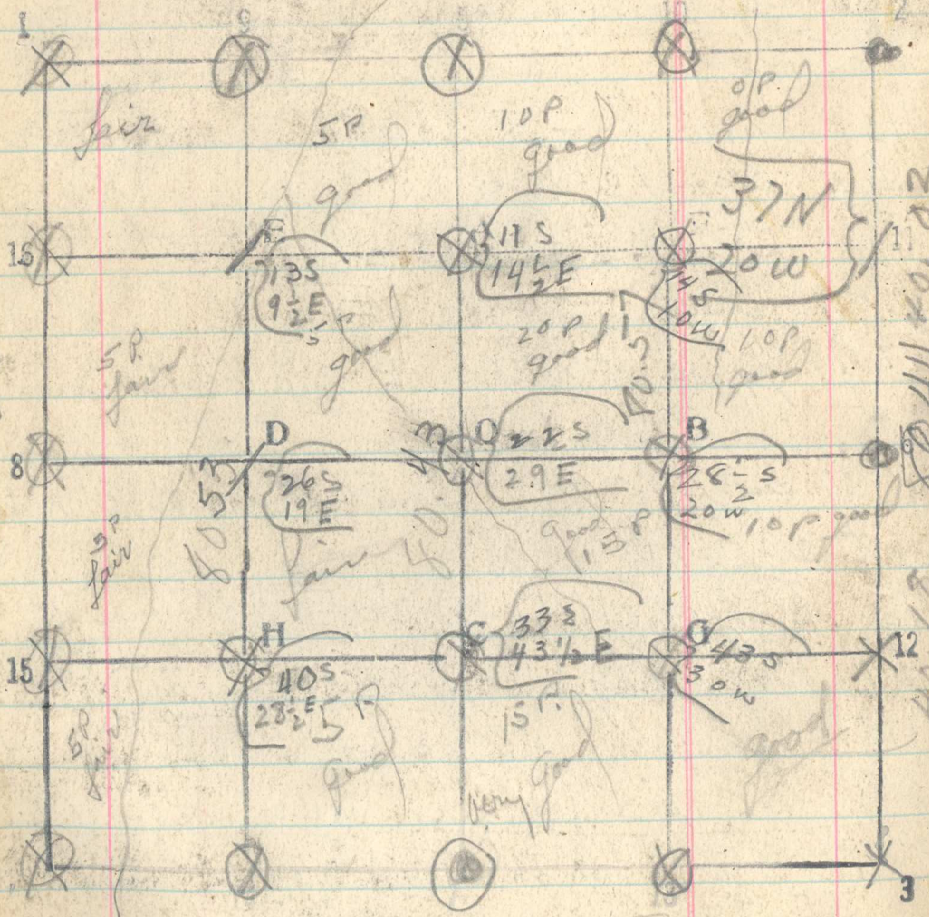


497

4/29 South Thru west half
Line 9–14
Set 20-40-60.
20.03 Buckeroo Cruk 10 lks. Blaze N 20 E.
80.68 1/16 cor 14 bears E. 38 lks

4/30. Line 5–7, South Thru outer
Set 20-40-60
41 bottom of cannon NW-SE.
80.43 1/4 cor 7 bears E 58 lks.
5/1. Line 10–13 South Thru East half
Set 20-40-60.
80.57 1/16 cor 13 bears W. 40 lks.

5/5 Flag line 1–2
1/16 Cor 9 bears N 2½ lks – 1/4 cor bears N 2½
1/16 Cor 10 bears S 8 lks. — Sec Cor on line
Flag line 3–4
1/16 cor 13 bears N 16 lks. – 1/4 cor bears N 40 lks
1/16 Cor 14 bears N. 78 lks.
Sec Cor bears N. 10.9 lks.