


24 Sec. 4 T. 2 R. 35

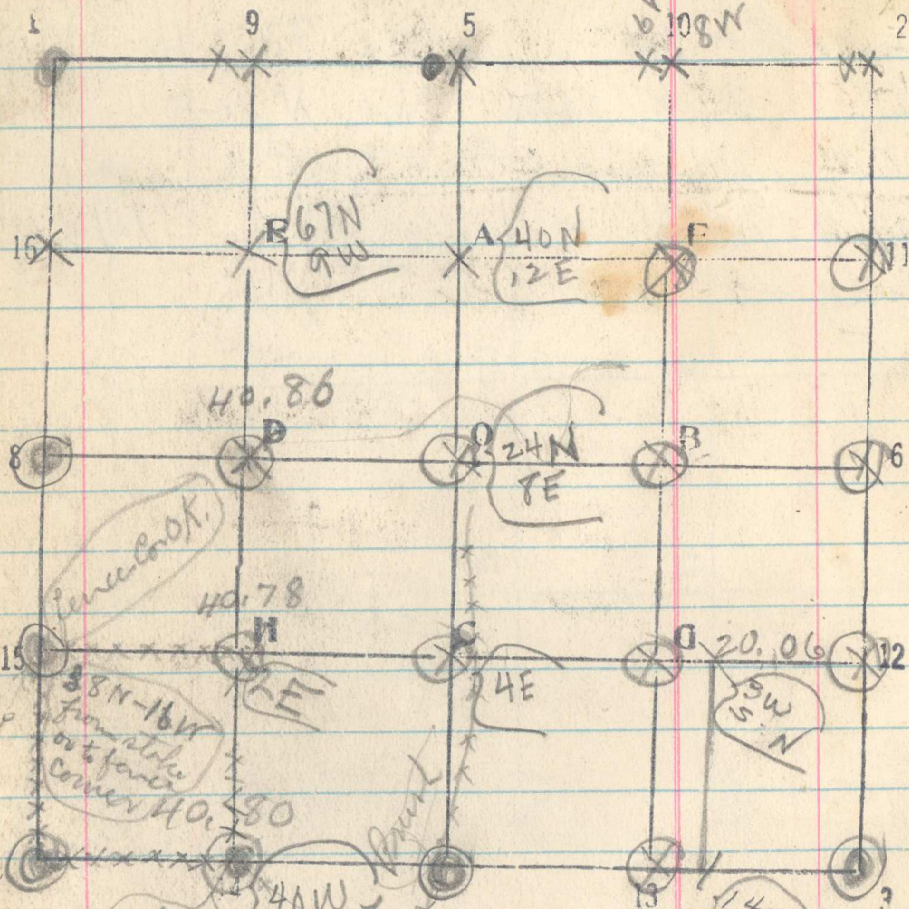

fence book
Some from stake
to fence
corner 40.30

40W
34N front stakes
and 60W + 21N from stone

5/10
line 12-9 (Rimmi)
let 15
20.04 1/16 cor of bear N 7 lks
5/10
line 3-13 (Rimmi)
let 15
20.19 1/16 cor 13 bears S 22 lks

| | |
|-----|-----------|
| 19 | 4/22 |
| 5 | 5 1/2 |
| 14W | 3 |
| | 16 1/2 S. |