Sec. 32 T. 2 N R. 35 E

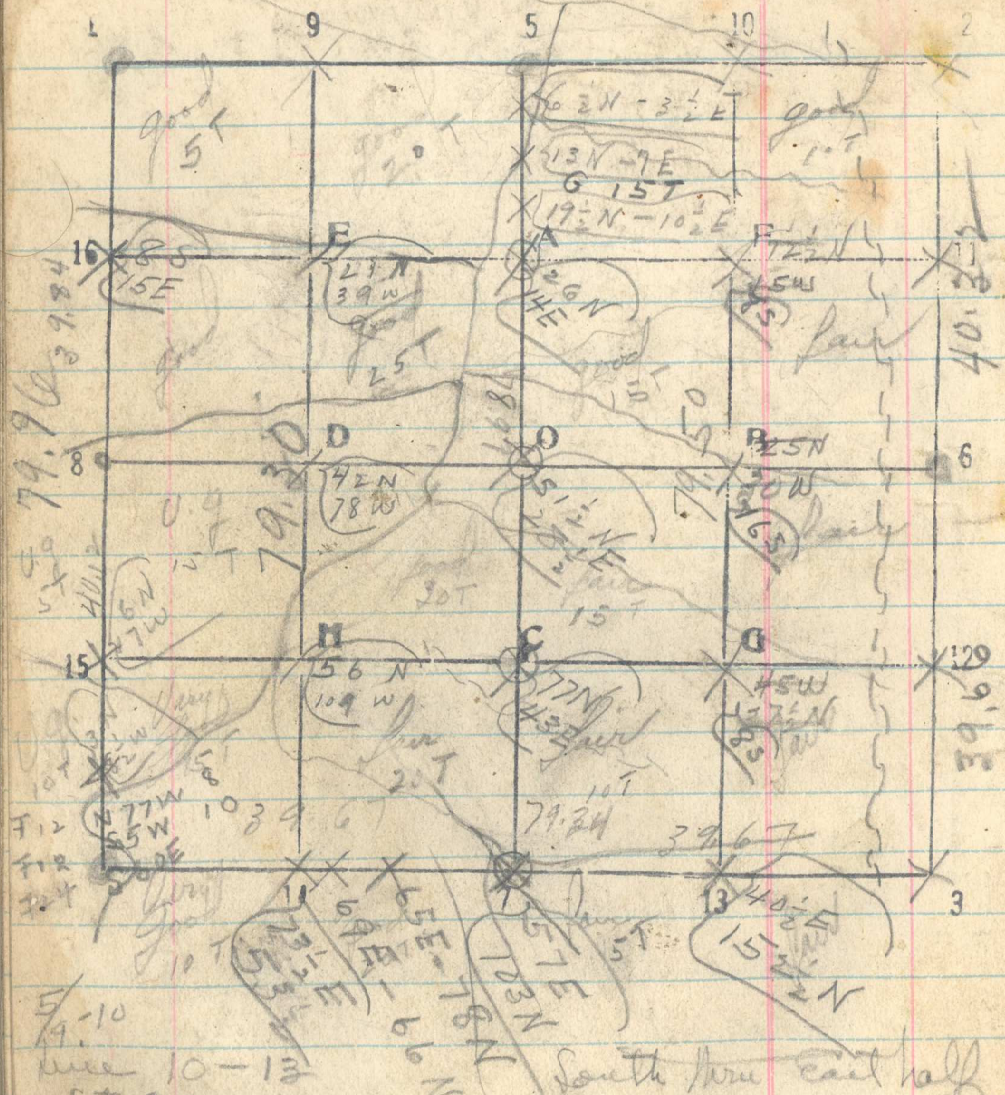

5/ 9.10
Line 10 – 13
Set 30 – 40 – 60
15 Ravine N 60 W 40 Ravine N 60 W
7 Ravine N 60 W
37.50 Meander 13 bears West 60 lks.

Line 9 – 14 – See former page

6/ 2 Line 5-7 South true Cor 508
with 1-S on 5 S 14'
Set. 5 – 10 – 15 – 20
9 Squaw Creek. Thds N 20 East
30 Ravine W. 14 Ravine N 70 W
80 No. true Corner. set in pit.
6/ 4 Line 7-3. Thence East
Set 20.
30 Ridge E/Squaw Crk Meadow Line N-S
40.24 Sec Cor 23-24-25-26 bears
North 202 lks.
6/ 4 Line 7-4. Project random line
7-3 West
Set 10 – 15 – 20.
7 Ravine Thds N W.
37.50 Squaw Creek. Thds N 40 W.
39.10 Sec Cor 22-23-26-27 bears
North 4 lks.
6/5 Line 4-8 North from Sec Cor 22-23-26-27
40.12 4 cor bears W 84 lks
6/5 Line 8-1 North from 4 from 1-S on Sec 23-24
39.84 Sec Cor 14-13-23-24 bears E.