


Sec. ³⁴ 33 T. 2 N R. 35 E

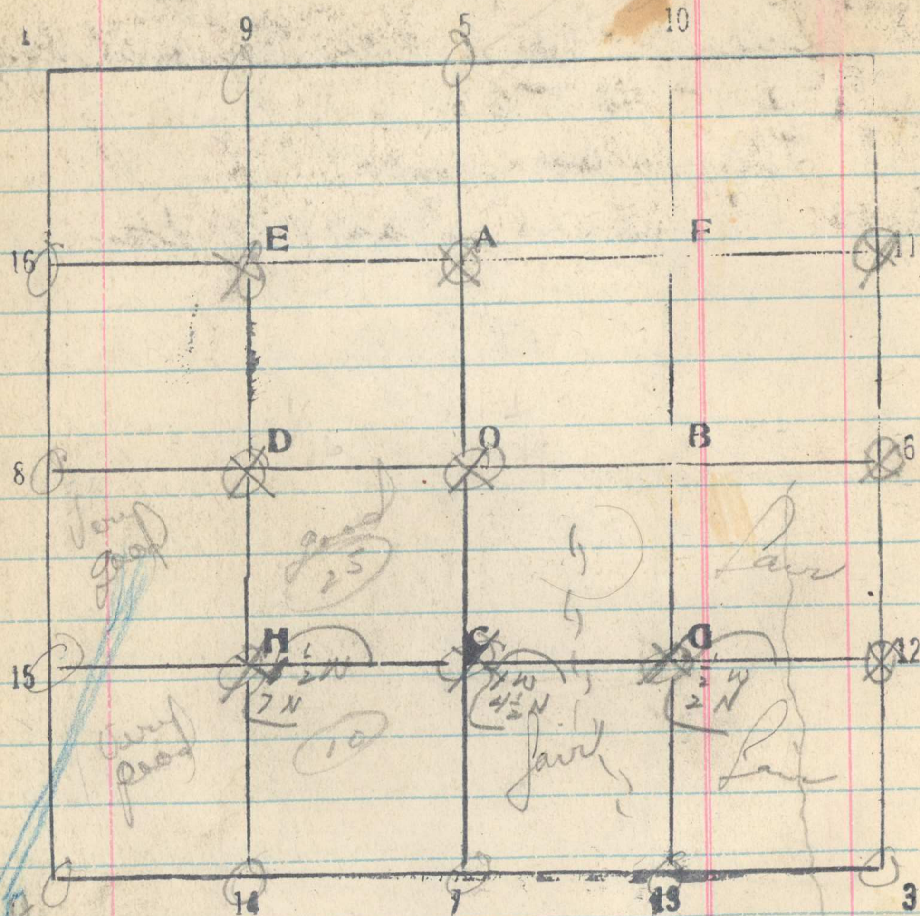

510

$\frac{1}{16}$ line 12-15, West thru South half.
 Set 20-40-60
 77 Lamy hollow - road - 1/2 line N-S.
 80.02 $\frac{1}{16}$ Cor. 15 bears N 9 W.