Sec. 14 36 T. 2 N R. 35 E

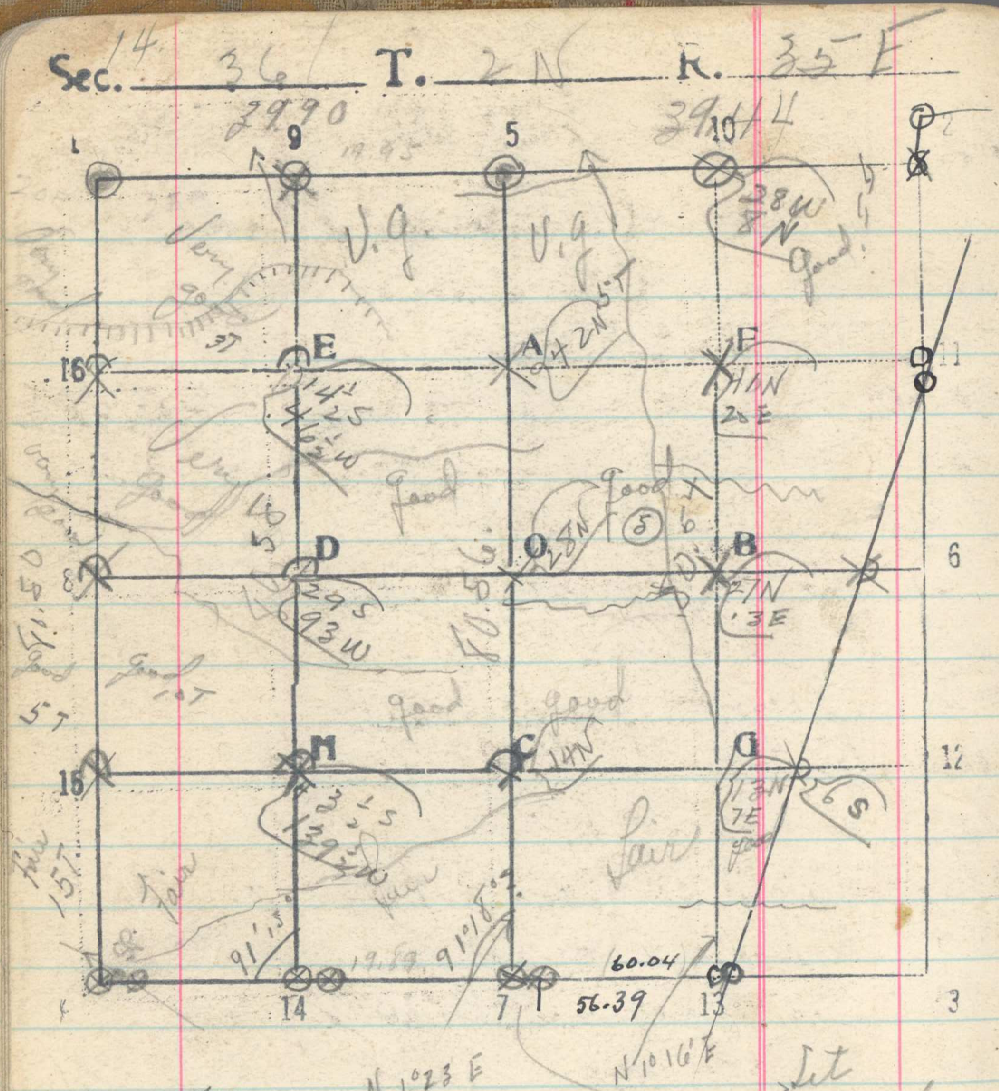

9/4 Flag East from C.

~~Temp 1/16 cor. G. from S bears S. 7 lks~~

1/16 cor. G bears N 6 lks

Boundary cor. lots 2 & 3 bears N 14 lks.

6/26 Line 1 - 4 South between 35 & 36

Set 20 - 40 - 60 (No sign of 1/4 cor.)

35 Ravine Sheds N 60 W.

~~80 Set temp Sec. cor.~~

80.50 Sec. cor. 35 & 36 West 168 lks

9/3 Line 9 - 14 South thru west half.

Set 20 - 40 - 60

27 Ravine Sheds S 70 W. 47 Ravine west

69 Ravine Sheds S 70 W.

80.58 1/16 cor. 14 bears W. 186 lks.

9/3 Line 7 - 5 North thru Center

Set 20 - 40 - 60

Ravines 17 Sheds W / 38 - E / 50 - W

80.56 1/4 cor. 5 on line

9/4 Line 13 - 10 North thru East half

Set 20 - 40 - 60.

Ravines 8 - E / 50 - W

80.54 1/16 cor. 10 bears E 26 lks