Sec. 26 T. 2N R. 25 E

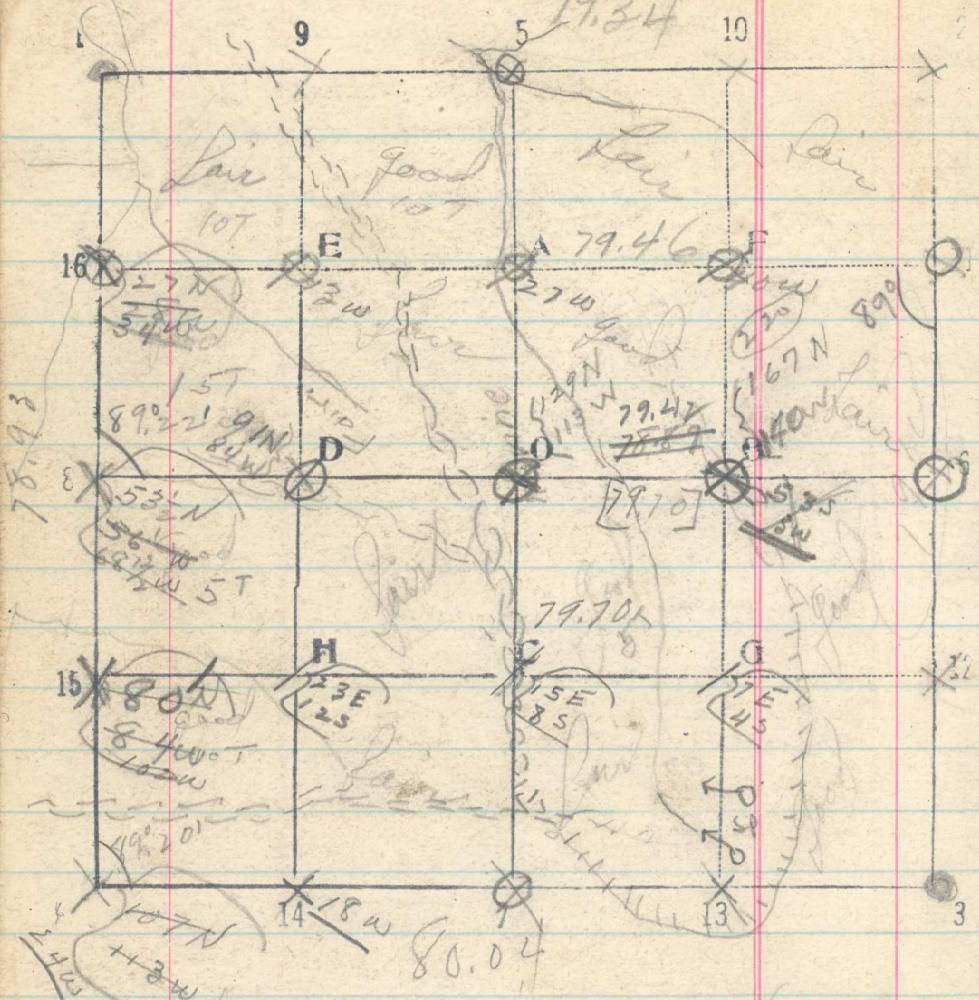
79.34
79.46
79.70
80.04
