Sec. 25 T. 3N R. 35E

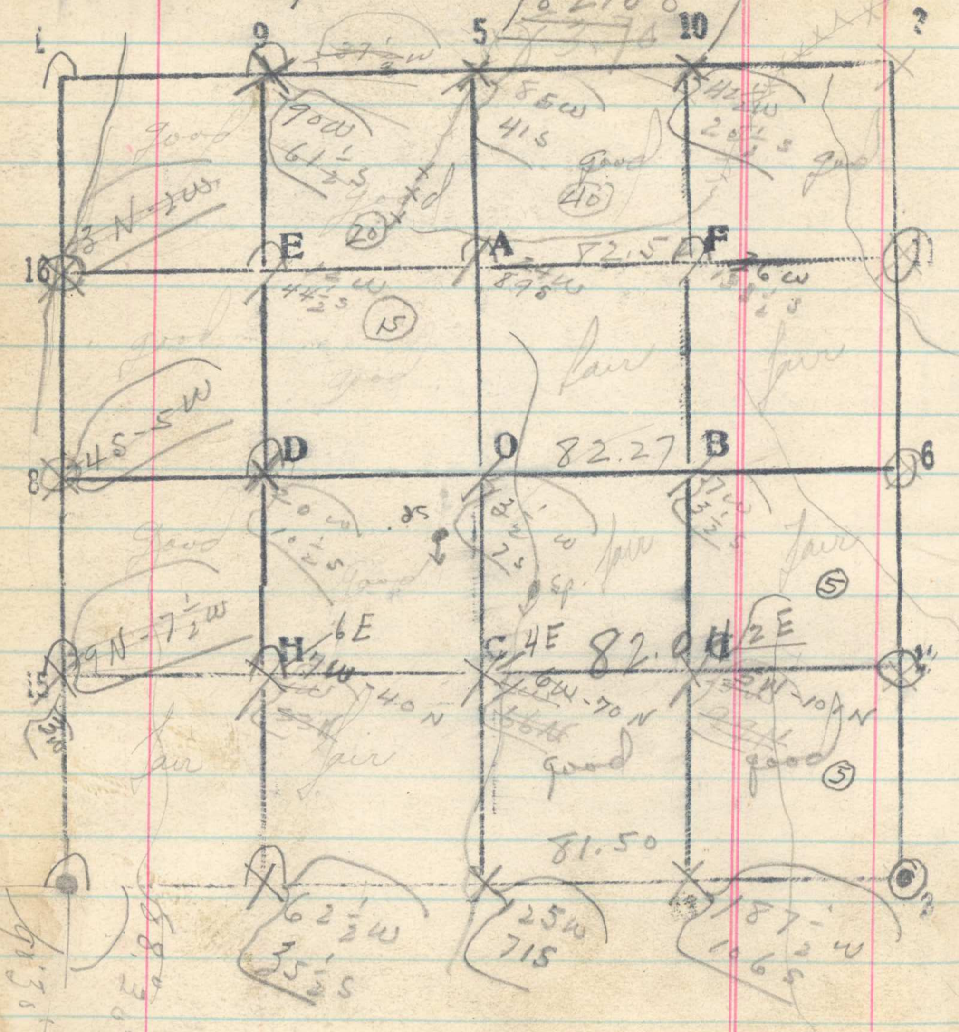

7/2 Line 4-3. East between 25 & 36

Set 21 - 42 - 63. (No sign of 1/4 cor)

10 Ravine Sheds S. 40 Ravine Sheds S.

81.50 Sec cor. 25-36-30-31 bears S. 142 lks.

7/2 Line 2-1 West between 25 & 24

Set 20.50-41 - 60.50 (No sign of 1/4 cor)

10 fence NE-SW. 40.50 fence N 30E - S 30W

75 Ravine Sheds South

83.70 Sec cor. 23-24-25-26 bears S 82 lks.

7/3 Line 15-12 East thru South half

Set 20.50 - 41 - 61.50

Ravines 10 S. - 42 S. - 68 S.

82.04 1/16 cor. bears N. 132 lks.

7/3 Line 6-8 West thru center

Set 20.50 - 41 - 61.50

Ravines 7 S. - 38 S.

82.27 1/16 cor 8 bears S 14 lks

7/8 Line 16-11 East thru N half.

Set 20.75 41.50-62.25

82.52 1/16 cor 11 bears S. 178 lks.