28

Sec. 17 T. 3N R. 36E

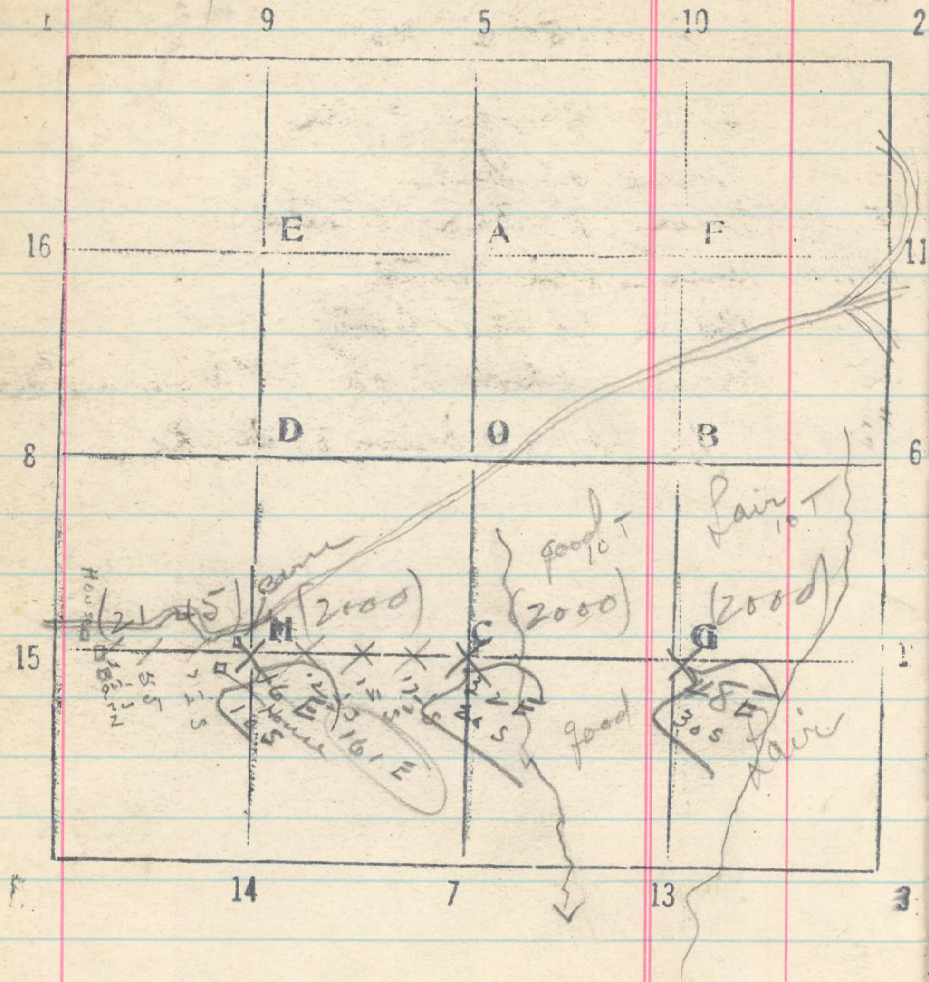

8/7 Line 15 - 12 East Thru South half.

Set 5 - 10 - 15 - 21.45 - 25 - 30
35 - 41.45 - 61.45

4 House 50 lks. North.
4.75 Barn on line
5.03 Fence North and South.
17.50 House 2 chs South
18.50 Barn 30 lks. North
45 Ravine sheds S. 10E, 72 Ravine Sheds S 10W
82.09 1/16 Cor, 12 bears S. 40 lks.