UMATILLA INDIAN RESERVATION.
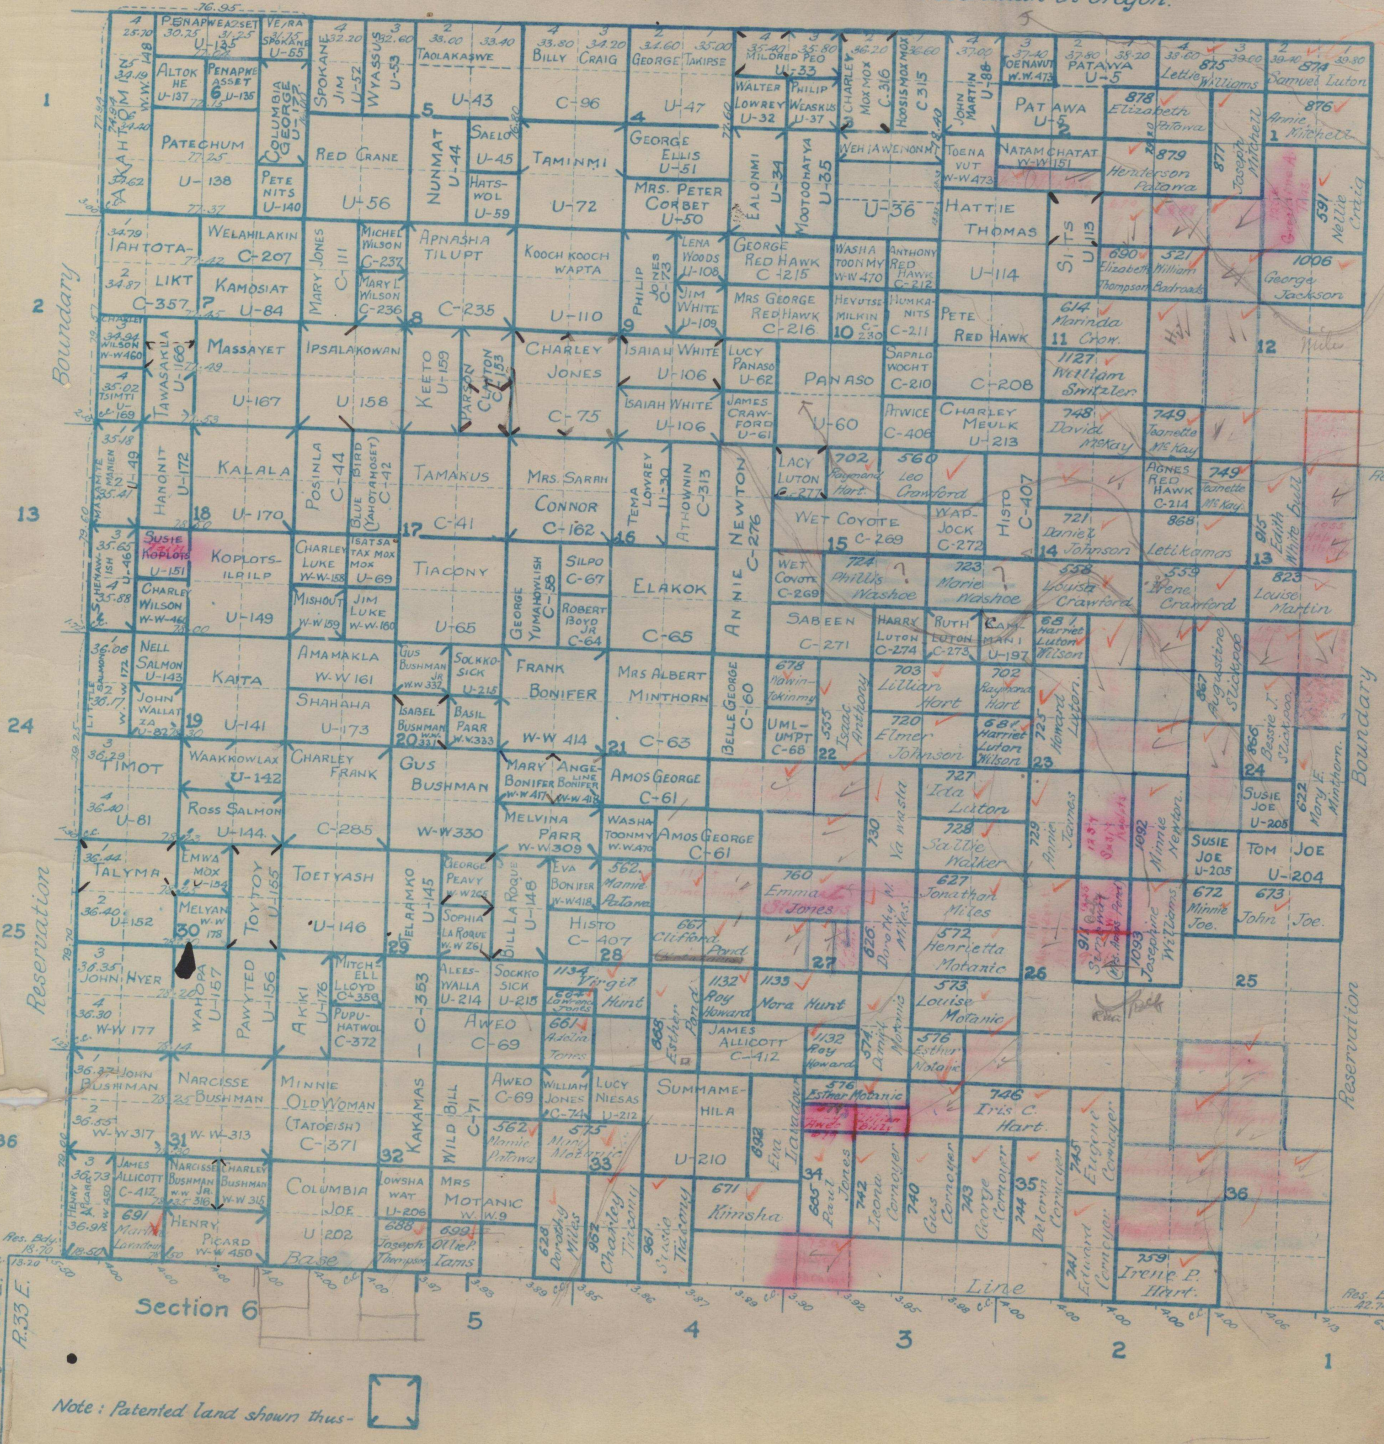
Township No. 1 North, Range No. 33 East. Willamette Meridian in Oregon.